



CITY OF PRINCE GEORGE

City of Prince George
History Sheet

PID:	008586624
MU:	
WO:	

Civic Address: 3031 Ridgeview Dr

Legal Description: Lot: 61 District Lot: 4046 Plan: 23142

Service Type	Diameter (mm)	Material	Invert Elev at main (m)	Invert Elev at property line (m)	Invert Depth at service end (m)	Distance into property (m)	Installation Date
Sanitary	100mm	PVC	745.86	746.26	-	-	July 2015
Water	20mm	Copper	746.46	746.43	-	-	July 2015
Storm	N/A	N/A	-	-	-	-	


Service Connection Location				Sanitary (m)	Storm (m)
Distance from downstream San MH	5541	towards upstream San MH	5542	13.12	
200mm Storm service connected to Recharge chamber					

Power	Size	Communications	Size	Cable	Size	Gas	Size
BC Hydro	-	Telus	-	Shaw	-	FortisBC	-
Overhead Service		Overhead Service		Overhead Service			

Installed by: City of Prince George forces Survey Date: -

Comments:

NOT TO SCALE The information contained herein is for internal use only.
Not to be relied on unless confirmed by site inspection and/or investigation.

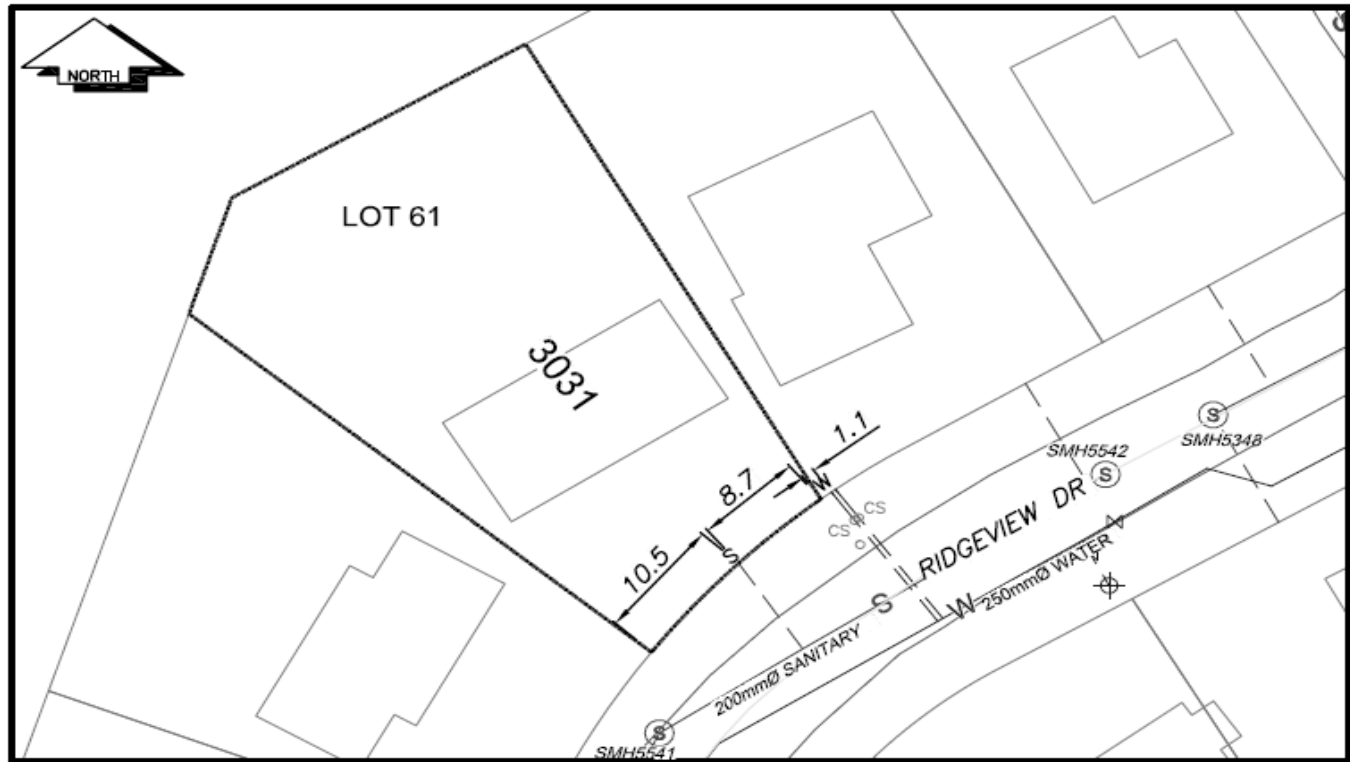

LEGEND:		
CS	CURB STOP	—
CO	CLEAN OUT	—
⊗	WATER VALVE	—
—	WATER SERVICE	—
- - -	SANITARY SERVICE	—
⊗	FIRE HYDRANT	—
—	STORM SERVICE	—
- - -	GAS	—
- - -	ENCUMBRANCE	

NOT TO SCALE

NOT TO SCALE