



City of Prince George
History Sheet

PID:	008586691
SD/MU:	
WO:	

Civic Address: 2959 Ridgeview Dr
Legal Description: Lot: 68 District Lot: 4046 Plan: 23142


Service Type	Diameter (mm)	Material	Invert Elev at main (m)	Invert Elev at property line (m)	Invert Elev at service end (m)	Distance into property (m)	Installation Date
Sanitary	100mm	PVC	740.67	741.27	-	-	July 2015
Water	20mm	Copper	740.47	740.61	-	-	July 2015
Storm	N/A	N/A	-	-	-	-	

Service Connection Location				Sanitary (m)	Storm (m)
Distance from downstream San MH	5539	towards upstream San MH	5539	6.93	
Distance from downstream Stm MH	-	towards upstream Stm MH	-		

Power	Size	Communications	Size	Cable	Size	Gas	Size
BC Hydro	-	Telus	-	Shaw	-	FortisBC	-
Underground Service		Underground Service		Underground Service			

Installed by:	City of Prince George forces	Survey Date:	-
Comments:			

NOT TO SCALE The information contained herein is for internal use only.
Not to be relied on unless confirmed by site inspection and/or investigation.

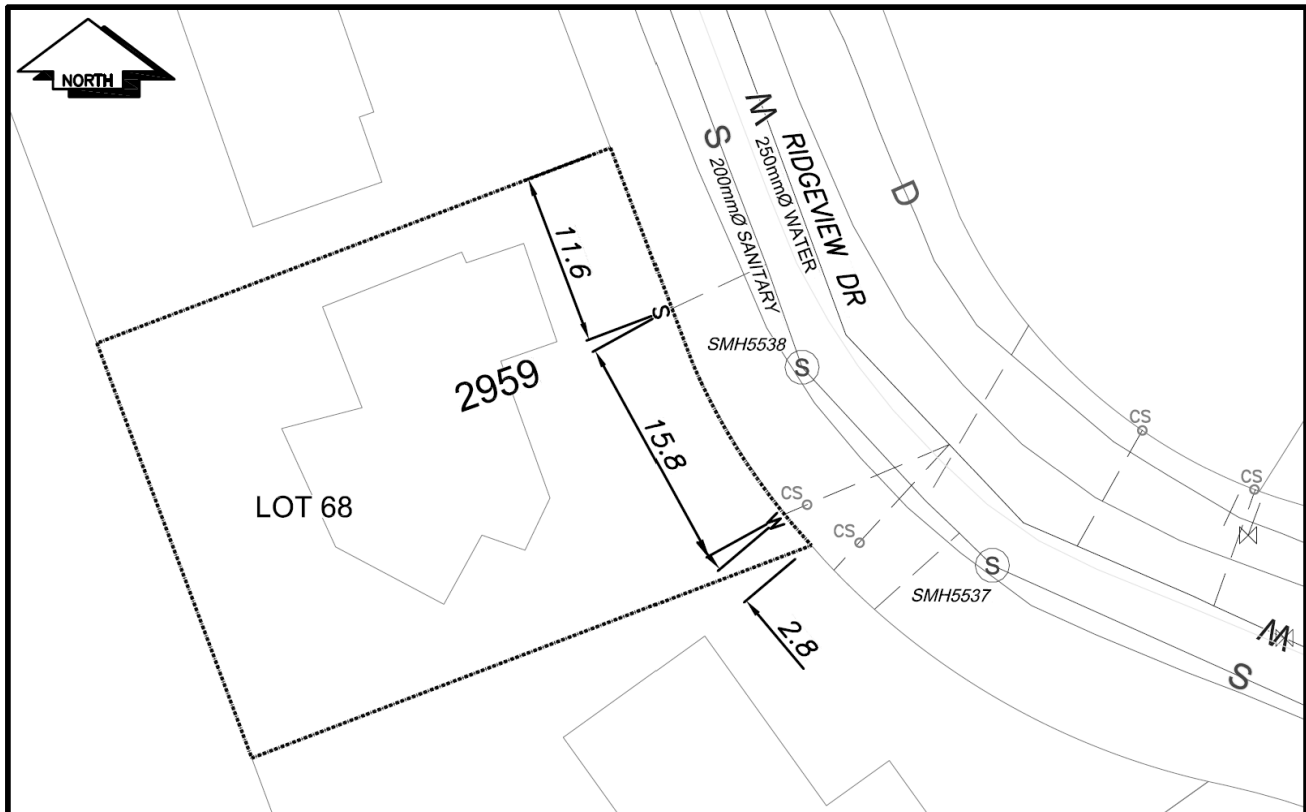

CS	CURB STOP	W	WATER SERVICE	○	STORM SERVICE
CO	CLEAN OUT	- - - S	SANITARY SERVICE	- G -	GAS
X	WATER VALVE	⊗	FIRE HYDRANT	- - -	ENCUMBRANCE

NOT TO SCALE