



City of Prince George
History Sheet

| | |
|--------|-----------|
| PID: | 008586969 |
| SD/MU: | |
| WO: | |

Civic Address: 2950 Ridgeview Dr
Legal Description: Lot: 75 District Lot: 4046 Plan: 23142


| Service Type | Diameter (mm) | Material | Invert Elev at main (m) | Invert Elev at property line (m) | Invert Elev at service end (m) | Distance into property (m) | Installation Date |
|--------------|---------------|----------|-------------------------|----------------------------------|--------------------------------|----------------------------|-------------------|
| Sanitary | 100mm | PVC | 740.26 | 741.17 | - | - | JULY 2015 |
| Water | 20mm | Copper | 739.92 | 740.86 | - | - | JULY 2015 |
| Storm | N/A | N/A | - | - | - | - | |

| Service Connection Location | | | | Sanitary (m) | Storm (m) |
|---------------------------------|------|-------------------------|------|--------------|-----------|
| Distance from downstream San MH | 5536 | towards upstream San MH | 5537 | 13.59 | |
| Distance from downstream Stm MH | - | towards upstream Stm MH | - | | |

| Power | Size | Communications | Size | Cable | Size | Gas | Size |
|------------------|------|------------------|------|------------------|------|----------|------|
| BC Hydro | - | Telus | - | Shaw | - | FortisBC | - |
| Overhead Service | | Overhead Service | | Overhead Service | | | |

| | | | |
|---------------|------------------------------|--------------|---|
| Installed by: | City of Prince George forces | Survey Date: | - |
| Comments: | | | |
| | | | |
| | | | |

NOT TO SCALE The information contained herein is for internal use only.
Not to be relied on unless confirmed by site inspection and/or investigation.

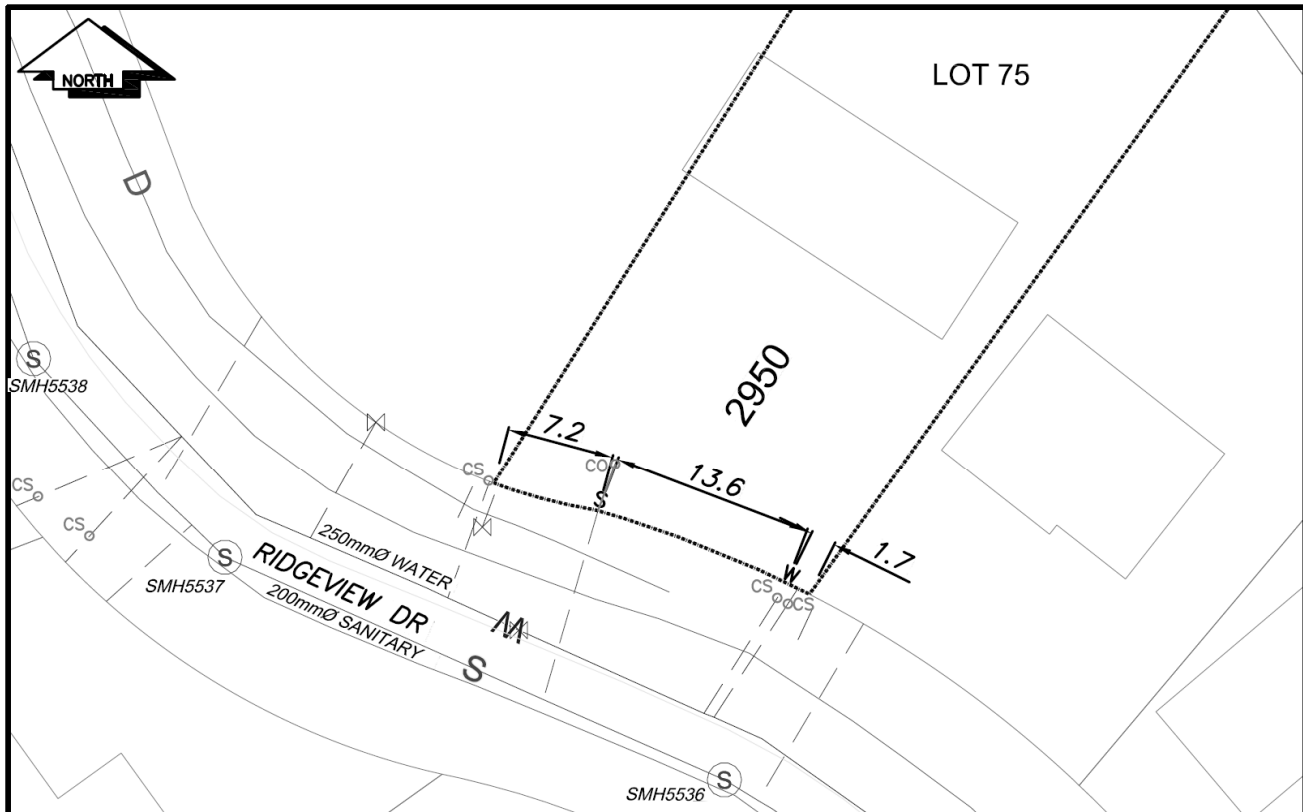

| LEGEND: | |
|-----------|------------------|
| CS | CURB STOP |
| CO | CLEAN OUT |
| ⊗ | WATER VALVE |
| — — | WATER SERVICE |
| - - - - - | SANITARY SERVICE |
| ⊗ | FIRE HYDRANT |
| —○— | STORM SERVICE |
| —G— | GAS |
| - - - - - | ENCUMBRANCE |

NOT TO SCALE