



City of Prince George
History Sheet

PID:	008588317
SD/MU:	
WO:	

Civic Address: 7080, 7082 7086, 7088, 7090, 7092 Domano Blvd
 Legal Description: Lot: 3 District Lot: 754 Plan: 23130


Service Type	Diameter (mm)	Material	Invert Elev at main (m)	Invert Elev at property line (m)	Invert Elev at service end (m)	Distance into property (m)	Installation Date
Sanitary	Unknown	PVC	-	-	-	-	January 1978
Water (W1)	Unknown	Unknown	-	-	-	-	January 1976
Water (W2)	150mm	AC	-	-	-	-	January 1976
Storm	Unknown	Unknown	-	-	-	-	January 1976

Service Connection Location				Sanitary (m)	Storm (m)
Distance from downstream San MH	-	towards upstream San MH	-	-	
Distance from downstream Stm MH	-	towards upstream Stm MH	-		

Power	Size	Communications	Size	Cable	Size	Gas	Size
BC Hydro	-	Telus	-	Shaw	-	FortisBC	-
Underground Service		Underground Service		Underground Service			

Installed by:		Survey Date:	-
Comments:			

NOT TO SCALE The information contained herein is for internal use only.
 Not to be relied on unless confirmed by site inspection and/or investigation.

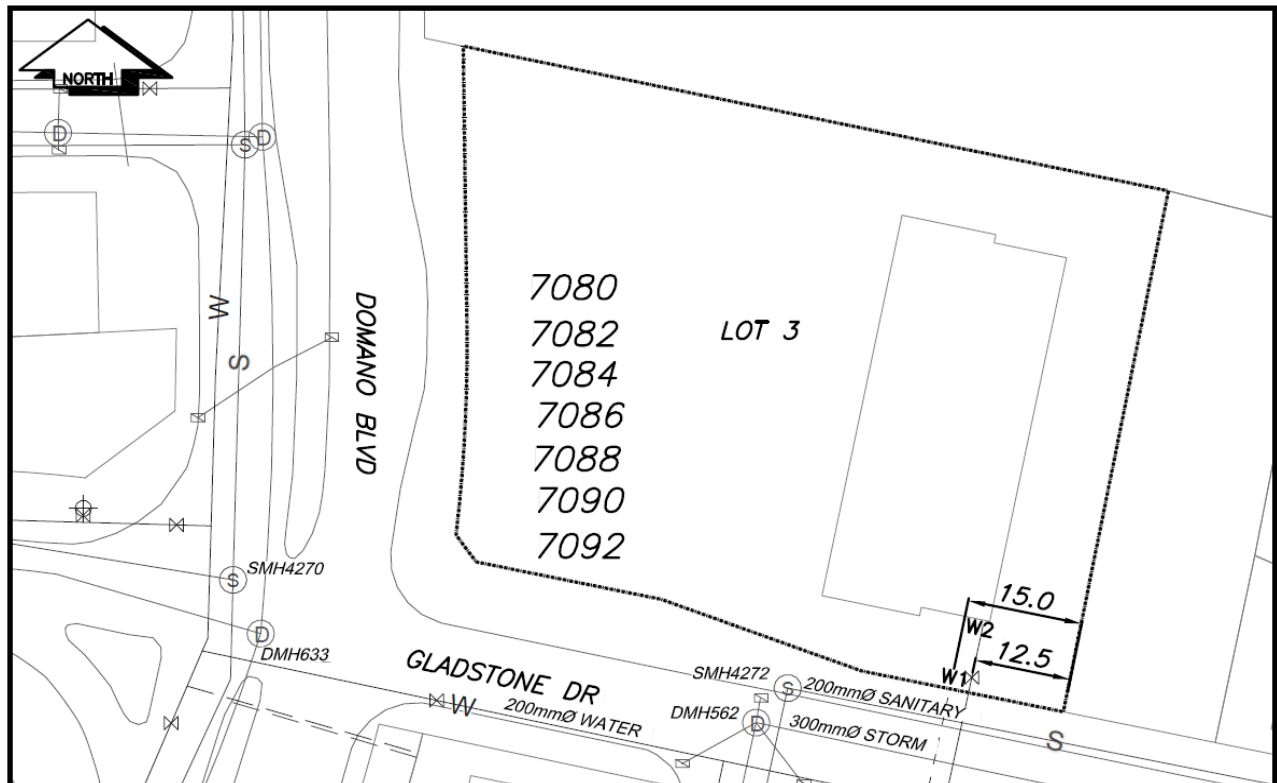

LEGEND:			
CS	CURB STOP	—	WATER SERVICE
CO	CLEAN OUT	- - -	SANITARY SERVICE
⊗	WATER VALVE	⊗	FIRE HYDRANT
		—	STORM SERVICE
		—G—	GAS
		- - -	ENCUMBRANCE

NOT TO SCALE