

**City of Prince George
HISTORY SHEET**

007500701

SHEET NUMBER **8452** Roll Number

Legal: LOT'S **32** BLOCK D.L. **2013** PLAN **23117**

Address: **8179 PRINCE EDWARD CRES**

Sanitary Connection: # SIZE **4"** MATERIAL ^{WT} **PVC** INV. CONNECTED

Water Connection # SIZE **3/4"** MATERIAL **COPPER** METER CONNECTED

Storm Connection: # SIZE **4"** MATERIAL **GR PVC** INV. CONNECTED

Cash Receipt No's: WATER SANITARY STORM

CURB FROM PROPERTY LINE **16'** PAVEMENT WIDTH **34'**


B.C. HYDRO **3'** UNDERGROUND CONNECTION

B.C. TELEPHONE **3'** UNDERGROUND CONNECTION

INLAND GAS **10'**



Information Sheets:

Comments: **66' R/W**

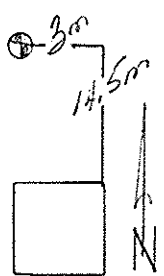

SITE
(31)

PLAN N.T.S.
(32)

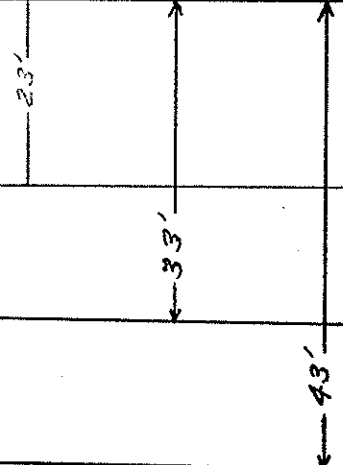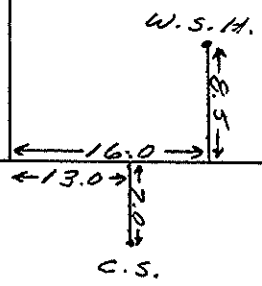

WATER

STORM

SEWER

