



City of Prince George
History Sheet

PID:	008623376
SD/MU:	
WO:	

Civic Address: 8064 Princeton Cres

Legal Description: Lot: 84 District Lot: 2013 Plan: 23118


Service Type	Diameter (mm)	Material	Invert Elev at main (m)	Invert Elev at property line (m)	Invert Elev at service end (m)	Distance into property (m)	Installation Date
Sanitary	100mm	PVC	-	-	-	-	December 1977
Water	20mm	Copper	-	-	-	-	December 1977
Storm	100mm	PVC	-	-	-	-	December 1977

Service Connection Location				Sanitary (m)	Storm (m)
Distance from downstream San MH	4584	towards upstream San MH	4585	63.67	
Distance from downstream Stm MH	1884	towards upstream Stm MH	1883		62.40

Power	Size	Communications	Size	Cable	Size	Gas	Size
BC Hydro	-	Telus	-	Shaw	-	FortisBC	-
Underground Service		Overhead Service		Underground Service			

Installed by:		Survey Date:	-
Comments:	Water service location confirmed July 2017		

NOT TO SCALE The information contained herein is for internal use only.
Not to be relied on unless confirmed by site inspection and/or investigation.

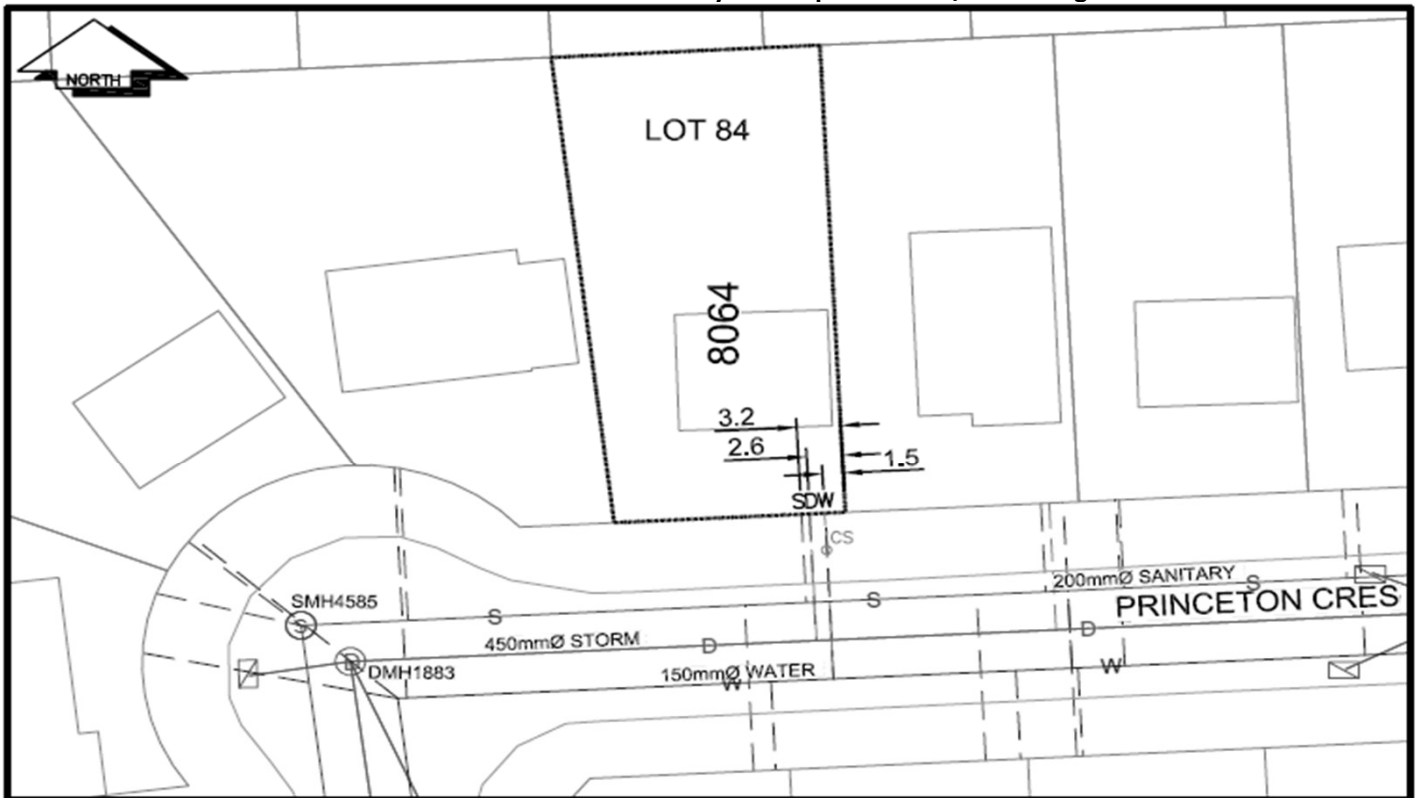

LEGEND:	
CS	CURB STOP
CO	CLEAN OUT
⊗	WATER VALVE
---	WATER SERVICE
---	SANITARY SERVICE
⊗	FIRE HYDRANT
---	STORM SERVICE
---	GAS
---	ENCUMBRANCE

NOT TO SCALE