



City of Prince George
History Sheet

PID:	008628807
SD/MU:	
WO:	

Civic Address: 7952 Loyola Cres

Legal Description: Lot: 13 District Lot: 2013 Plan: 23008


Service Type	Diameter (mm)	Material	Invert Elev at main (m)	Invert Elev at property line (m)	Invert Elev at service end (m)	Distance into property (m)	Installation Date
Sanitary	100mm	PVC	-	-	-	-	December 1977
Water	20mm	Copper	-	-	-	-	December 1977
Storm	100mm	PVC	-	-	-	-	December 1977

Service Connection Location				Sanitary (m)	Storm (m)
Distance from downstream San MH	4632	towards upstream San MH	4327	58.63	
Distance from downstream Stm MH		towards upstream Stm MH			

Power	Size	Communications	Size	Cable	Size	Gas	Size
BC Hydro	-	Telus	-	Shaw	-	FortisBC	-
Underground Service		Underground Service		Underground Service			

Installed by:	Survey Date:	-
Comments: Water Service location confirmed August 2017		
Old history sheet indicates that there is a 100mm PVC storm service to the property - to be confirmed with further investigation		

NOT TO SCALE The information contained herein is for internal use only.
Not to be relied on unless confirmed by site inspection and/or investigation.

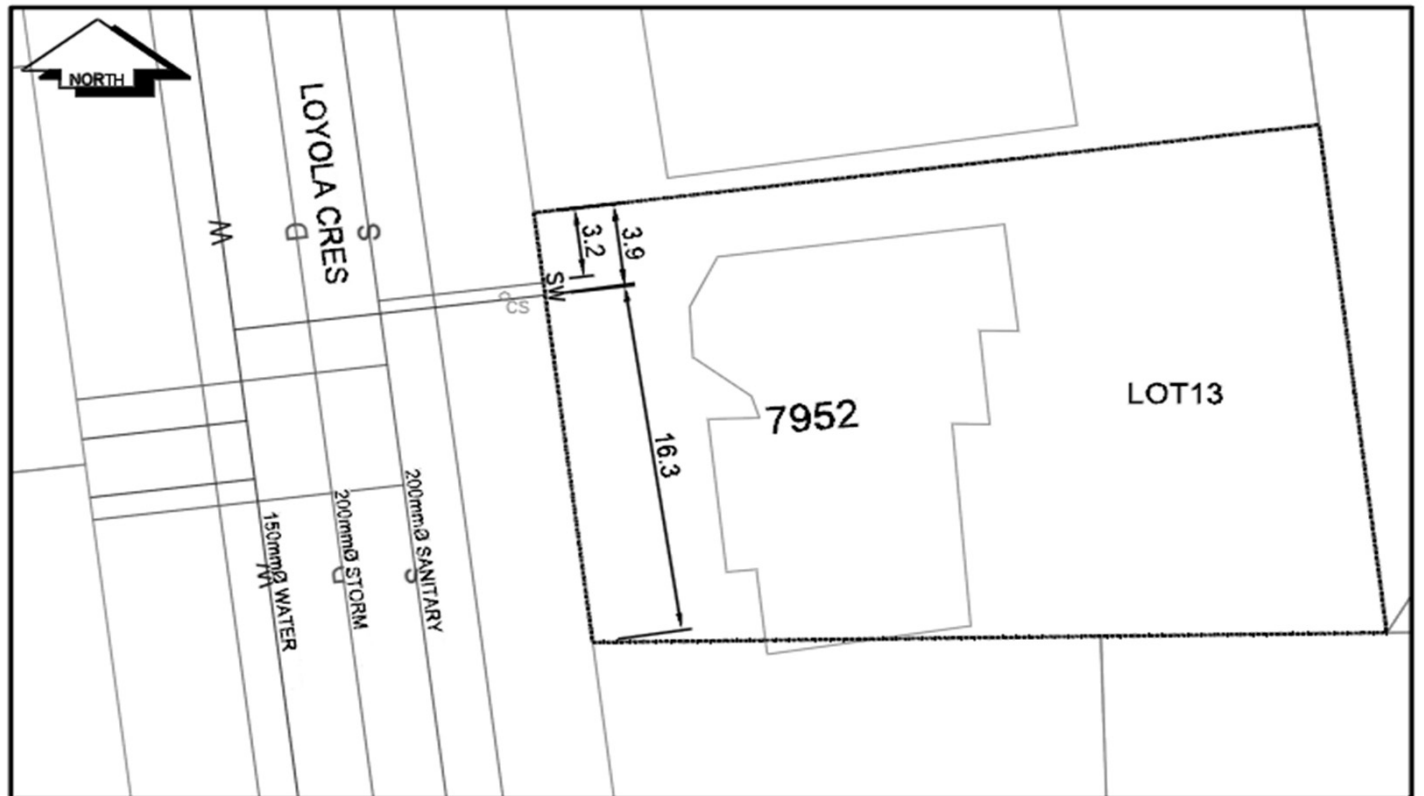

LEGEND:					
CS	CURB STOP	W	WATER SERVICE	○	STORM SERVICE
CO	CLEAN OUT	S	SANITARY SERVICE	—G—	GAS
⊗	WATER VALVE	⊕	FIRE HYDRANT	- - - -	ENCUMBRANCE

NOT TO SCALE