



City of Prince George
History Sheet

PID:	008648255
SD/MU:	
WO:	

Civic Address: 8311 Flamingo Rd

Legal Description: Lot: 42 District Lot: 2424 Plan: 22967


Service Type	Diameter (mm)	Material	Invert Elev at main (m)	Invert Elev at property line (m)	Invert Depth at service end (m)	Distance into property (m)	Installation Date
Sanitary	100mm	PVC	-	762.40	1.20	-	December 1985
Water	20mm	Copper	-	-	-	-	December 1971
Storm	N/A	N/A	-	-	-	-	

Service Connection Location				Sanitary (m)	Storm (m)
Distance from downstream San MH	4787	towards upstream San MH	47/85	47.31	
Distance from downstream Stm MH	-	towards upstream Stm MH	-		

Power	Size	Communications	Size	Cable	Size	Gas	Size
BC Hydro	-	Telus	-	Shaw	-	FortisBC	-
Overhead Service		Overhead Service		Overhead Service			

Installed by:	Survey Date:	-
Comments:		

NOT TO SCALE The information contained herein is for internal use only.
Not to be relied on unless confirmed by site inspection and/or investigation.

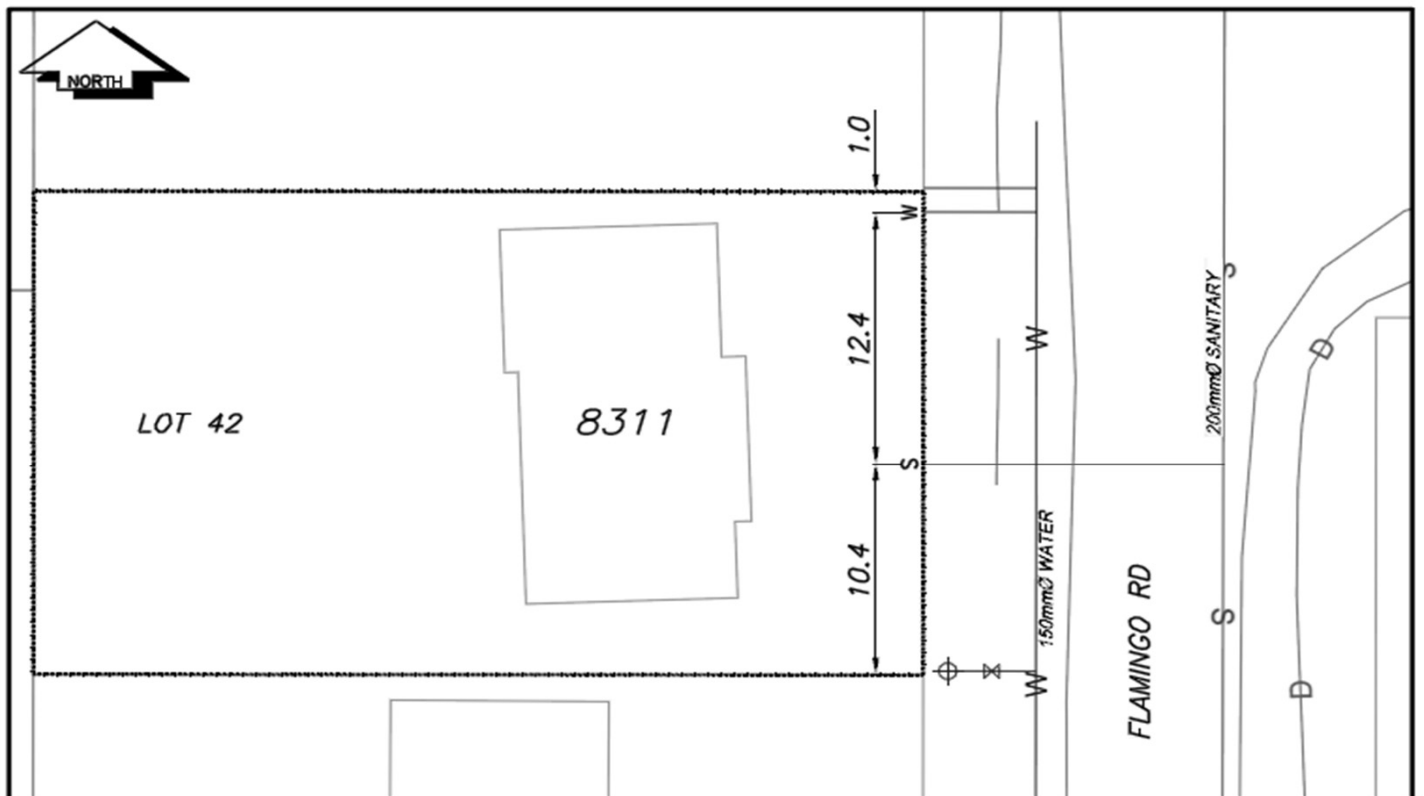

LEGEND:	
CS	CURB STOP
CO	CLEAN OUT
⊗	WATER VALVE
W	WATER SERVICE
S	SANITARY SERVICE
⊗	FIRE HYDRANT
D	STORM SERVICE
G	GAS
- - - -	ENCUMBRANCE

NOT TO SCALE