
City of Prince George HISTORY SHEET

SHEET NUMBER					Roll Number	00867/958
Legal: LOT'S 203		вьоск	D.	<i>482</i>	PLAN	22883
Address: 165 SKI	INNER ST.					
Sanitary Connection: #	10624	SIZE 4"	MATERIAL A.	C INV.	92.76	CONNECTED
Water Connection #	10624	SIZE 3/4"	MATERIAL C	O MET	er No	CONNECTED
Storm Connection: #		SIZE	MATERIAL	INV.	No.	CONNECTED
Cash Receipt No's:	WATER		SANITARY		STORM	
CURB FROM PROPERTY LINE				PAV	EMENT WIDTH	
B.C. HYDRO	UNDERGROUND CONNECTION					
B.C. TELEPHONE	UNDERGROUND CONNECTION					
INLAND GAS						
Information Sheets:						
Comments: BM 200	13.63 H.S	SE COR	1 st SKINI	VER		
	-					
		SITE	PLAN N.T.S	3.		

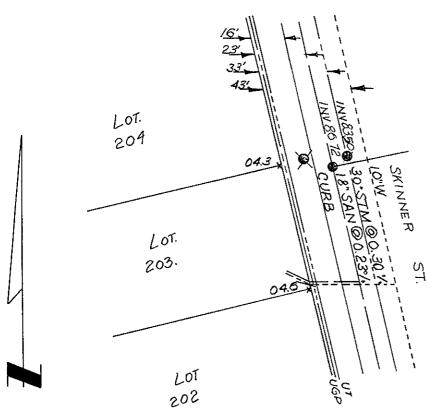

10.0m 0.6m