



City of Prince George  
**History Sheet**

PID:	008699836
MU:	101207
WO:	60335

Civic Address: 357 Mullett Cres

Legal Description: Lot: 15 District Lot: 482 Plan: 22883


Service Type	Diameter (mm)	Material	Invert Elev at main (m)	Invert Elev at property line (m)	Invert Elev at service end (m)	Distance into property (m)	Installation Date
Sanitary	100mm	AC	-	609.10	-	-	January 1976
Water	20mm	Copper	-	-	-	-	January 1976
Water	50mm	Copper	-	-	-	-	August 2011
Storm	100mm	PVC	-	608.70	-	-	January 1976

Service Connection Location				Sanitary (m)	Storm (m)
Distance from downstream San MH	2433	towards upstream San MH	2434	1.90	
Distance from downstream Stm MH	311	towards upstream Stm MH	313		3.60

Power	Size	Communications	Size	Cable	Size	Gas	Size
BC Hydro	-	Telus	-	Shaw	-	FortisBC	-
Underground Service		Underground Service		Underground Service			

Installed by:	City of Prince George forces	Survey Date:	-
Comments:	50mm Water service installed in same trench as existing 20mm water service.		

**NOT TO SCALE** The information contained herein is for internal use only.  
Not to be relied on unless confirmed by site inspection and/or investigation.

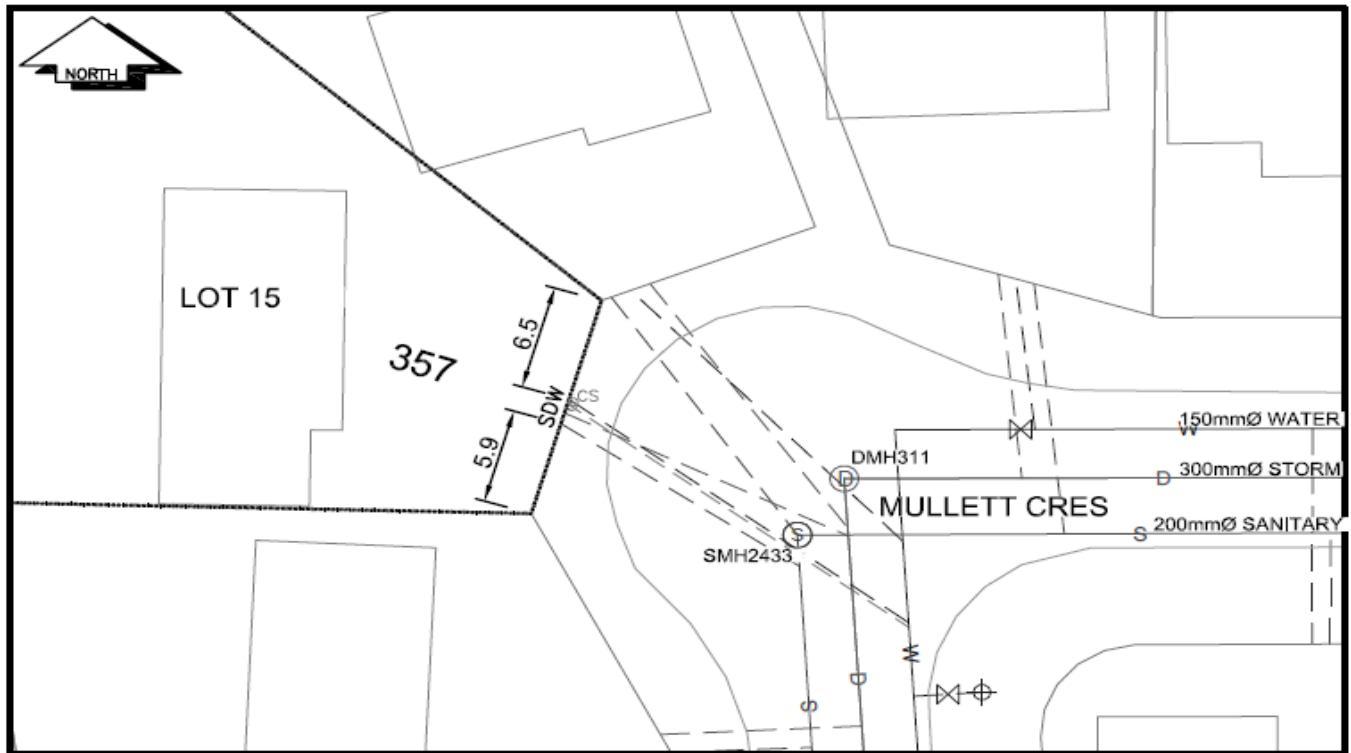

CS	CURB STOP	W	WATER SERVICE	D	STORM SERVICE
CO	CLEAN OUT	S	SANITARY SERVICE	G	GAS

**NOT TO SCALE**