

**City of Prince George
HISTORY SHEET**

FM

SHEET NUMBER **4411** Roll Number **008 700 389**

Legal: LOT'S **39** BLOCK D.L. **482** PLAN **22883**

Address: **331 KILLOREN CRES**

Sanitary Connection: # SIZE **1"** MATERIAL **A.C.** INV. **02.66** CONNECTED

Water Connection # **10461** SIZE **3/4"** MATERIAL **PLASTIC** METER **None** CONNECTED

Storm Connection: # SIZE **4"** MATERIAL **P.V.C.** INV. **03.22** CONNECTED

Cash Receipt No's: WATER SANITARY STORM

CURB FROM PROPERTY LINE PAVEMENT WIDTH



B.C. HYDRO UNDERGROUND CONNECTION

B.C. TELEPHONE UNDERGROUND CONNECTION

INLAND GAS

Information Sheets:

Comments: **BIA-2008.31 NSIDE KILLOREN BET L 74 & 75**
CONN CENTRED ON LOT

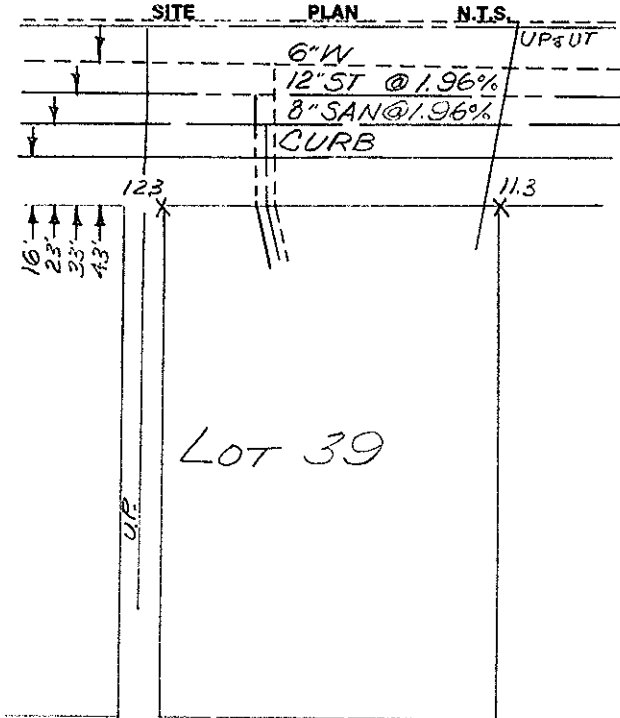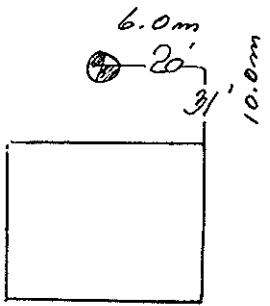

KILLOREN CRES.

LOT 39

