



City of Prince George
History Sheet

PID:	008725802
SD/MU:	
WO:	

Civic Address: 4549 Delta Pl

Legal Description: Lot: 49 District Lot: 2507 Plan: 22809


Service Type	Diameter (mm)	Material	Invert Elev at main (m)	Invert Elev at property line (m)	Invert Elev at service end (m)	Distance into property (m)	Installation Date
Sanitary	100mm	PVC	-	-	-	-	December 1975
Water	20mm	Copper	-	-	-	-	December 1976
Storm	N/A	N/A	-	-	-	-	

Service Connection Location	Sanitary (m)	Storm (m)
100mm sanitary service is connected to San MH2775	-	
Distance from downstream Stm MH - towards upstream Stm MH -		

Power	Size	Communications	Size	Cable	Size	Gas	Size
BC Hydro	-	Telus	-	Shaw	-	FortisBC	-
Underground Service		Underground Service		Underground Service			

Installed by:	Survey Date:	-
Comments: Water locate confirmed August 06, 2017		

NOT TO SCALE The information contained herein is for internal use only.
Not to be relied on unless confirmed by site inspection and/or investigation.

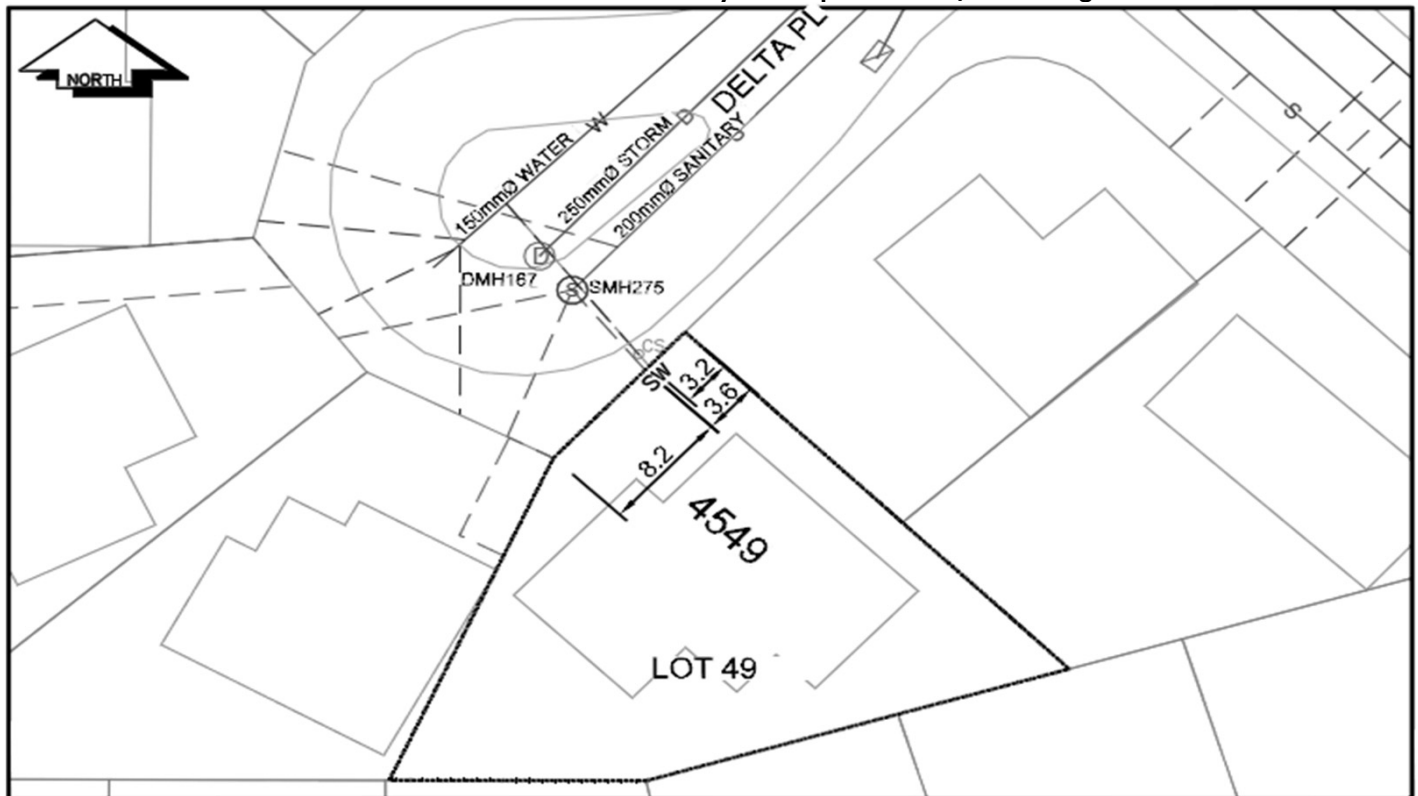

LEGEND:	
CS ^o CURB STOP	--- WATER SERVICE
CO ^o CLEAN OUT	--- SANITARY SERVICE
⊗ WATER VALVE	--- STORM SERVICE
	--- GAS
	⊕ FIRE HYDRANT
	--- ENCUMBRANCE

NOT TO SCALE