



City of Prince George
History Sheet

PID:	008746516
	008746524
SD/MU:	
WO:	5004285

Services 1005 Burden St

Civic Address: 1025 Burden St

Legal Description: Lot: 3, 4 Block: 87 District Lot: 343 Plan: 1268

Service Type	Diameter (mm)	Material	Invert Elev at main (m)	Invert Elev at property line (m)	Invert Elev at service end (m)	Distance into property (m)	Installation Date
Sanitary	100mm	AC	-	-	-	-	December 1956
Water (W1)	20mm	Copper	585.67	586.23	-	-	November 2016
Water (W2)	20mm	Copper	585.81	586.12	-	-	November 2016
Storm	N/A	N/A		-	-	-	


Service Connection Location			Sanitary (m)	Storm (m)
Distance from downstream San MH	3080	towards upstream San MH	-	
Distance from downstream Stm MH	-	towards upstream Stm MH	-	

Power	Size	Communications	Size	Cable	Size	Gas	Size
BC Hydro	-	Telus	-	Shaw	-	FortisBC	-
Overhead Service		Overhead Service		Overhead Service			

Installed by: Water services (W1) & (W2) installed by City of Prince George forces Survey Date: -

Comments:

NOT TO SCALE The information contained herein is for internal use only.
Not to be relied on unless confirmed by site inspection and/or investigation.

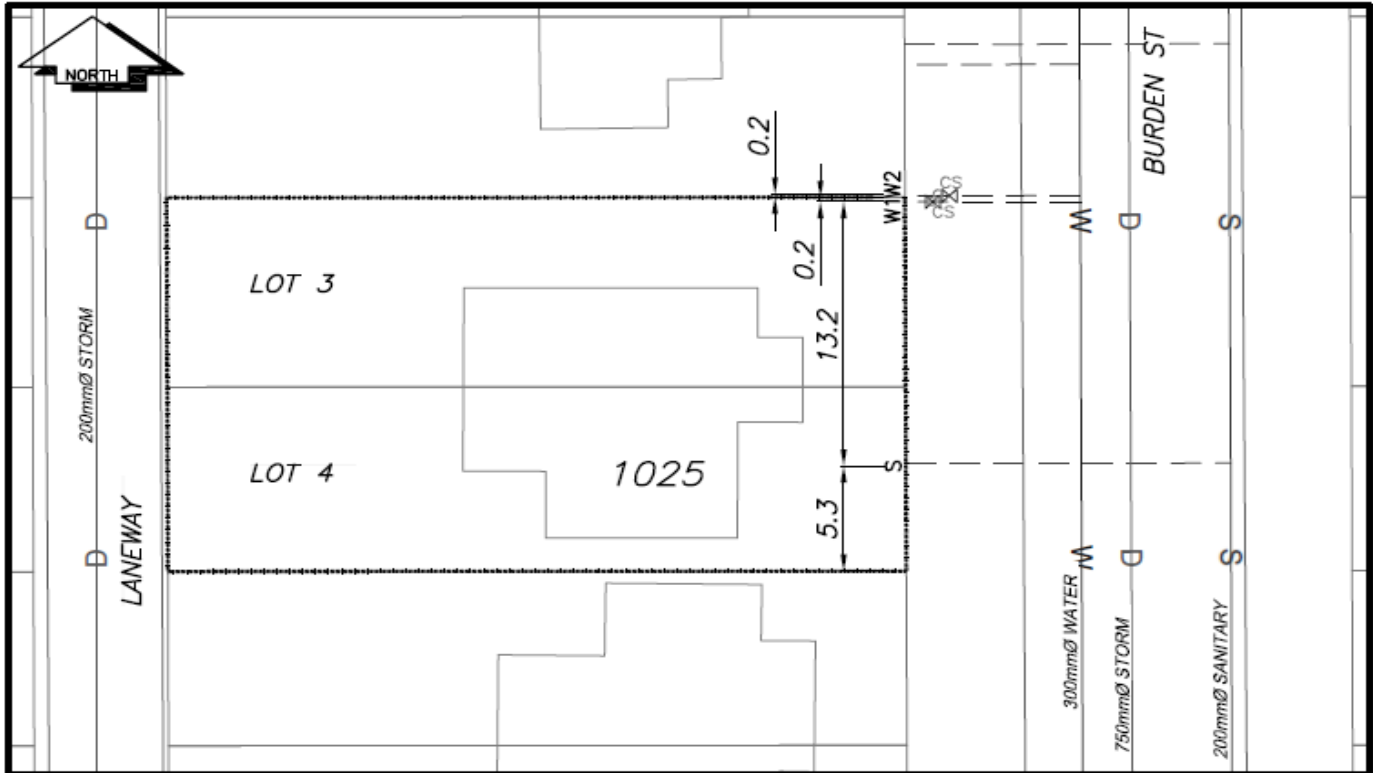

LEGEND:

CS ^o CURB STOP	— W — WATER SERVICE	— S — STORM SERVICE
CO ^o CLEAN OUT	- - - S - - - SANITARY SERVICE	— G — GAS
⊗ WATER VALVE	⊗ FIRE HYDRANT	- - - ENCUMBRANCE

NOT TO SCALE