



City of Prince George  
**History Sheet**

PID:	008785902
SD/MU:	
WO:	

Civic Address: 1380 Pearson Ave

Legal Description: Lot: A District Lot: 1426 Plan: 22789


Service Type	Diameter (mm)	Material	Invert Elev at main (m)	Invert Elev at property line (m)	Invert Elev at service end (m)	Distance into property (m)	Installation Date
Sanitary	100mm	AC	-	-	-	-	December 1969
Water	20mm	Copper	-	-	-	-	December 1969
Storm	N/A	N/A	-	-	-	-	

Service Connection Location				Sanitary (m)	Storm (m)
Distance from downstream San MH	2995	towards upstream San MH	3506	-	
Distance from downstream Stm MH	-	towards upstream Stm MH	-		

Power	Size	Communications	Size	Cable	Size	Gas	Size
BC Hydro	-	Telus	-	Shaw	-	FortisBC	-
Overhead Service		Overhead Service		Overhead Service			

Installed by:		Survey Date:	-
Comments:	Sanitary & Water service confirmed September 02, 2020		

**NOT TO SCALE** The information contained herein is for internal use only.  
Not to be relied on unless confirmed by site inspection and/or investigation.

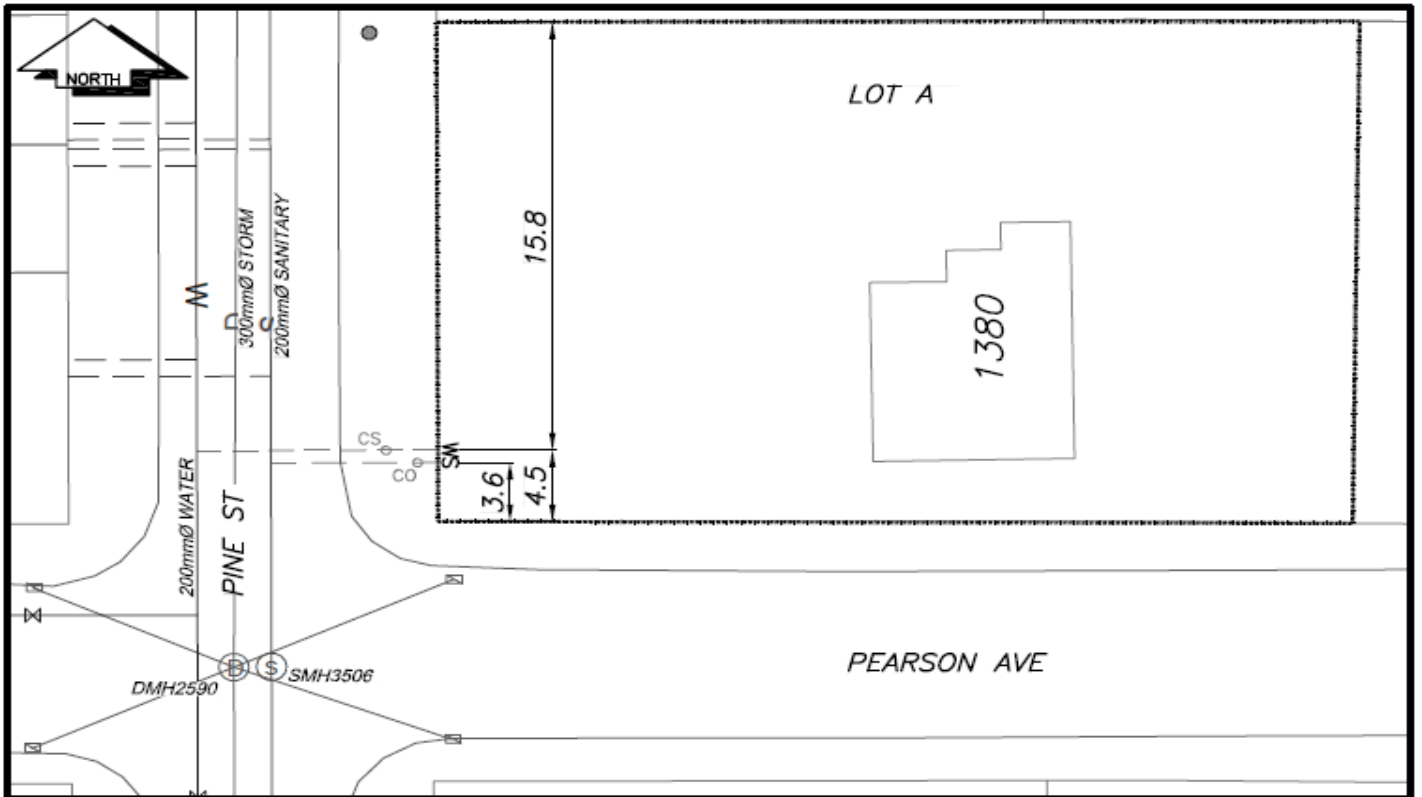

LEGEND:	
CS <sup>o</sup>	CURB STOP
CO <sup>o</sup>	CLEAN OUT
⊗	WATER VALVE
—W—	WATER SERVICE
- - - S	SANITARY SERVICE
⊗	FIRE HYDRANT
—G—	GAS
- - -	ENCUMBERANCE
—o—	STORM SERVICE

**NOT TO SCALE**