



City of Prince George
History Sheet

PID:	008807931
SD/MU:	
WO:	

Civic Address: 667 Alward St

Legal Description: Lot: A District Lot: 343 Plan: 22705


Service Type	Diameter (mm)	Material	Invert Elev at main (m)	Invert Elev at property line (m)	Invert Depth at service end (m)	Distance into property (m)	Installation Date
Sanitary	100mm	AC	-	-	2.25	-	December 1957
Water	20mm	Copper	-	-	-	-	December 1957
Storm	N/A	N/A	-	-	-	-	

Service Connection Location				Sanitary (m)	Storm (m)
Distance from downstream San MH	2677	towards upstream San MH	2672	46.50	
Distance from downstream Stm MH	-	towards upstream Stm MH	-		

Power	Size	Communications	Size	Cable	Size	Gas	Size
BC Hydro	-	Telus	-	Shaw	-	FortisBC	-
Overhead Service		Overhead Service		Overhead Service			

Installed by:	Survey Date:	-
Comments:		

NOT TO SCALE The information contained herein is for internal use only.
Not to be relied on unless confirmed by site inspection and/or investigation.

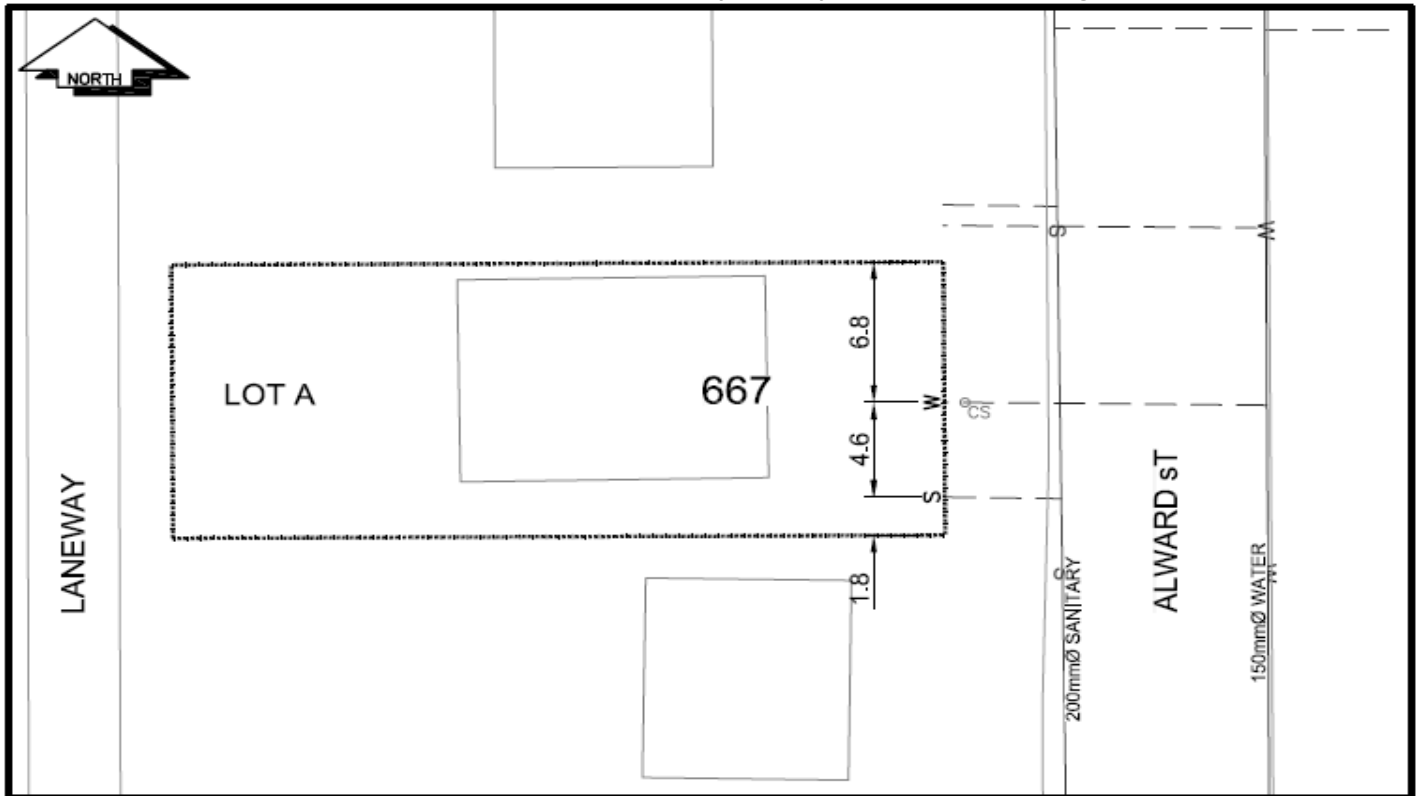

LEGEND:	
CS ^o	CURB STOP
CO ^o	CLEAN OUT
⊗	WATER VALVE
---	WATER SERVICE
---	SANITARY SERVICE
⊕	FIRE HYDRANT
---	STORM SERVICE
---	GAS
---	ENCUMBRANCE

NOT TO SCALE