

# City of Prince George HISTORY SHEET

008 019 71

SHEET NUMBER \_\_\_\_\_ Roll Number \_\_\_\_\_

Legal: LOT'S **25** BLOCK **16** D.L. **932** PLAN **796**

Address: **2325 NORWOOD STREET**

Sanitary Connection: # \_\_\_\_\_ SIZE **100 mm** MATERIAL **PVC** INV. **565.40** CONNECTED

Water Connection # \_\_\_\_\_ SIZE **20 mm** MATERIAL **COPPER** METER \_\_\_\_\_ CONNECTED

Storm Connection: # \_\_\_\_\_ SIZE \_\_\_\_\_ MATERIAL \_\_\_\_\_ INV. \_\_\_\_\_ CONNECTED

Cash Receipt No's: WATER \_\_\_\_\_ SANITARY \_\_\_\_\_ STORM \_\_\_\_\_

CURB FROM PROPERTY LINE **0.5** PAVEMENT WIDTH **9.5**

B.C. HYDRO **OH** UNDERGROUND CONNECTION

B.C. TELEPHONE **OH** UNDERGROUND CONNECTION


INLAND GAS \_\_\_\_\_

Information Sheets: \_\_\_\_\_


Comments: \_\_\_\_\_

\_\_\_\_\_

\_\_\_\_\_

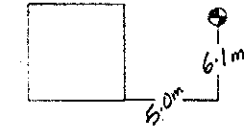

SITE PLAN N.T.S.

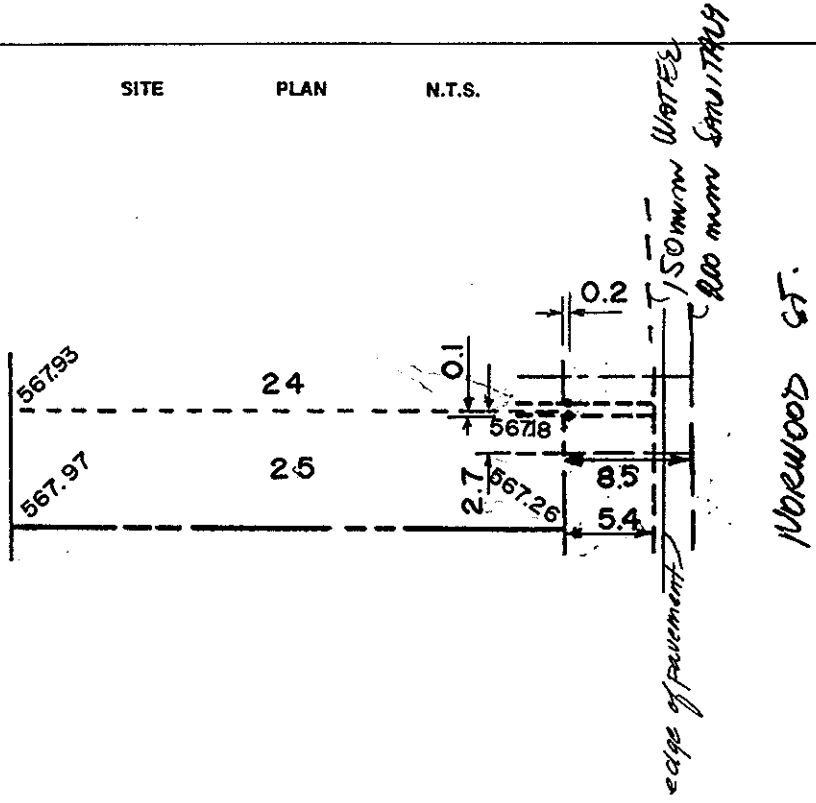

NORWOOD ST.