

City of Prince George HISTORY SHEET

SHEET NUMBER

Roll Number 008816 191

Legal: LOT'S B

BLOCK

D.L. 754+2013 PLAN 22665

Address: LOYOLA DRIVE

Sanitary Connection: # SIZE 100mm MATERIAL A.C. INV. _____ CONNECTED _____

Water Connection # SIZE 20mm MATERIAL Cu METER _____ CONNECTED _____

Storm Connection: # SIZE _____ MATERIAL _____ INV. _____ CONNECTED _____

Cash Receipt No's: WATER _____ SANITARY _____ STORM _____

CURB FROM PROPERTY LINE 4.572m PAVEMENT WIDTH 10.973m


B.C. HYDRO _____ UNDERGROUND CONNECTION _____

B.C. TELEPHONE _____ UNDERGROUND CONNECTION _____

INLAND GAS _____

Information Sheets:

Comments: connections for sanitary and water on property south of LOT B.

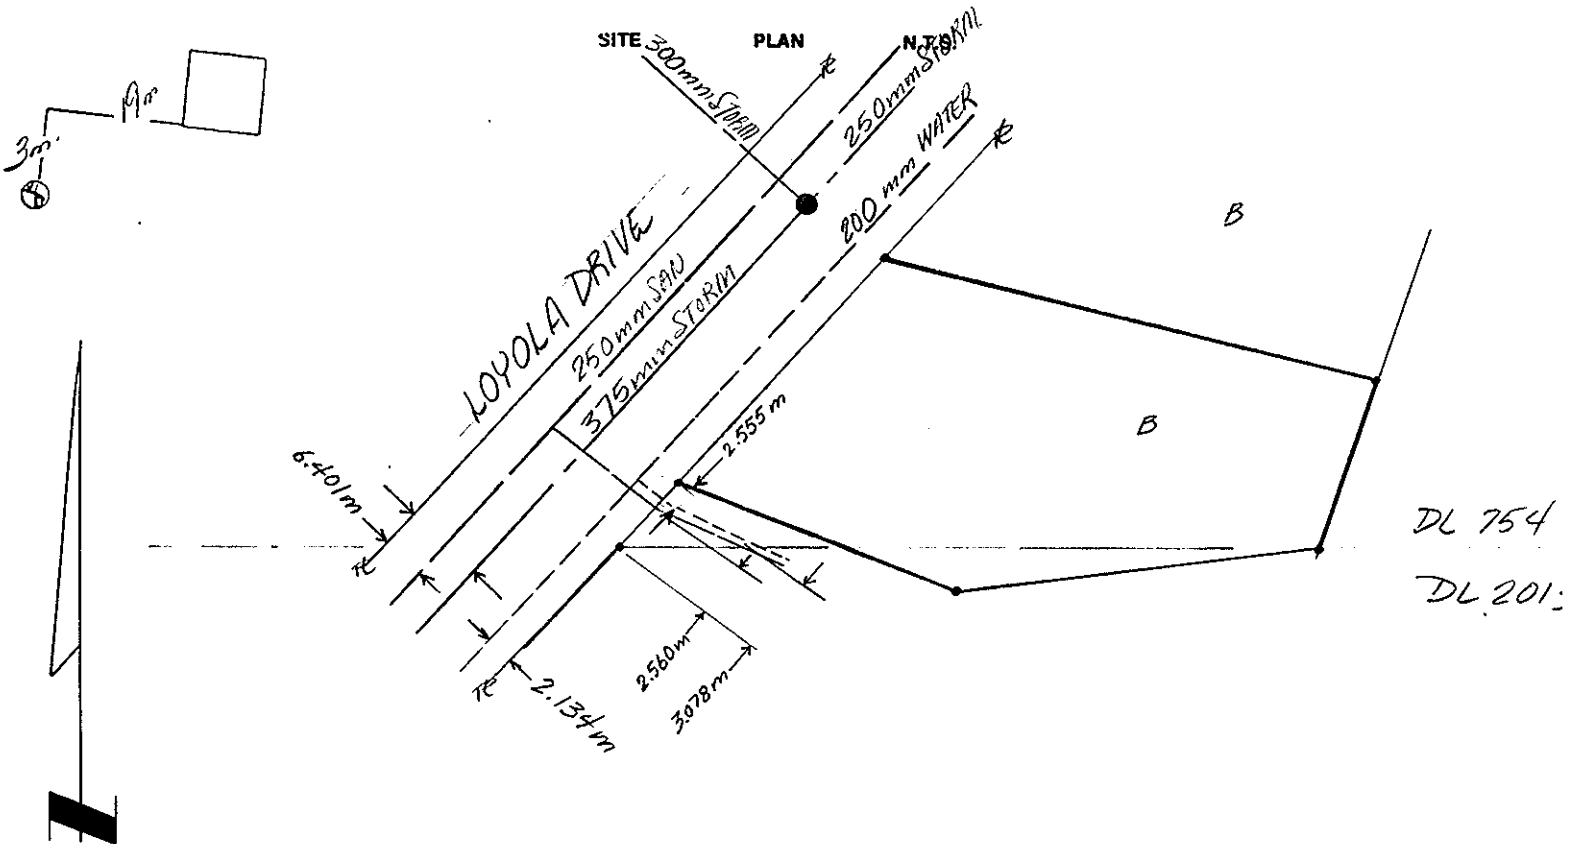

DL 754
DL 201: