



City of Prince George
History Sheet

PID:	008852251
SD/MU:	
WO:	

Civic Address: 2816 Langley Cres

Legal Description: Lot: 30 District Lot: 4046 Plan: 22626


Service Type	Diameter	Material	Invert Elev at main	Invert Elev at property line	Invert Elev service end	Distance into property	Installation Date
Sanitary	100mm	PVC	1.00	1.25	2.00	3.00	August 2014
Water	20mm	Copper	-	-	-	-	
Storm	N/A	N/A	-	-	-	-	

Service Connection Location				Sanitary	Storm
Distance from downstream San MH	939	towards upstream San MH	5332	64.8m	
Distance from downstream Stm MH	-	towards upstream Stm MH	-		

Power	Size	Communications	Size	Cable	Size	Gas	Size
BC Hydro	-	Telus	-	Shaw	-	FortisBC	-
Overhead Service		Overhead Service		Overhead Service			

Installed by:	City of Prince George forces	Survey Date:	August 2014
Comments:			

NOT TO SCALE The information contained herein is for internal use only.
Not to be relied on unless confirmed by site inspection and/or investigation.

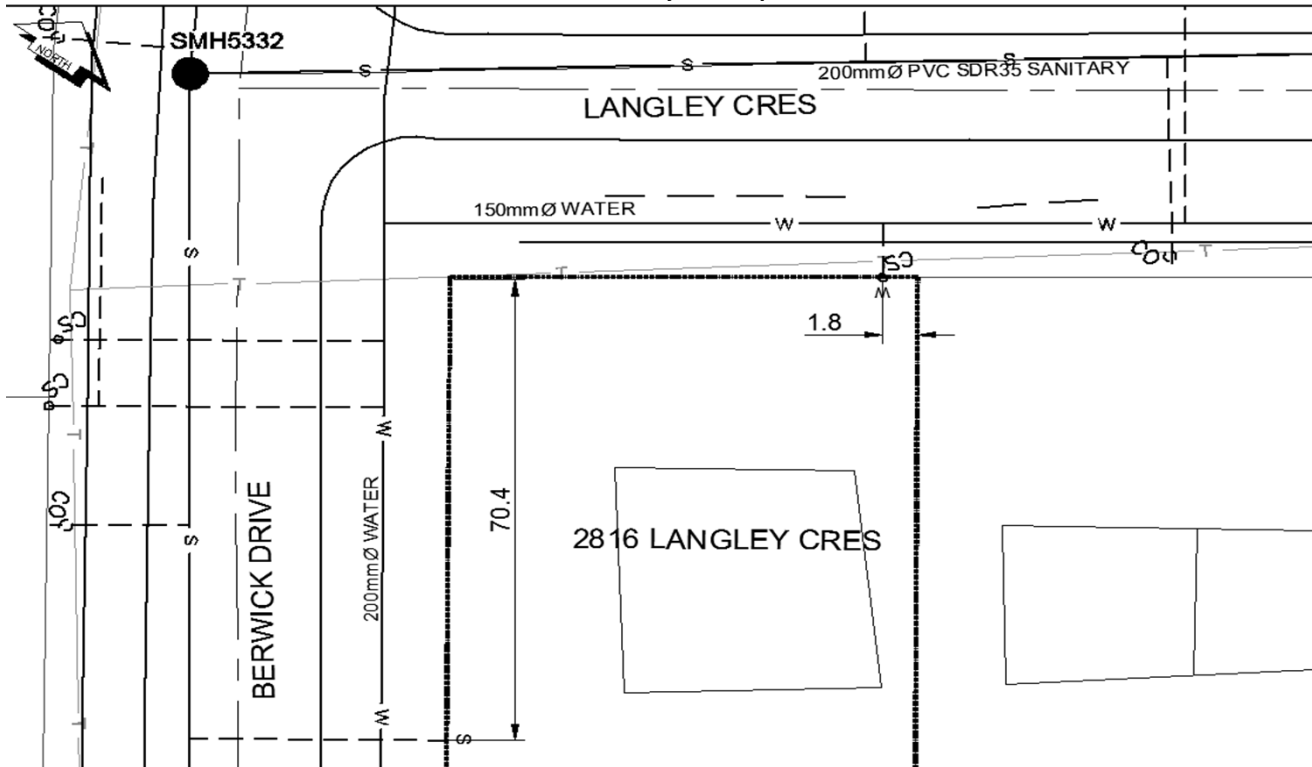

Legend:	CURB STOP	CLEAN OUT	WATER SERVICE	SANITARY SERVICE	GAS	OVERHEAD POWER & COMMUNICATIONS
---------	-----------	-----------	---------------	------------------	-----	---------------------------------

NOT TO SCALE