



City of Prince George  
**History Sheet**

PID:	008852260
SD/MU:	
WO:	

Civic Address: 2829 Langley Cres

Legal Description: Lot: 31 District Lot: 4046 Plan: 22626


Service Type	Diameter	Material	Invert Elev at main	Invert Elev at property line	Invert Elev service end	Distance into property	Installation Date
Sanitary	100mm	PVC	742.89	-	743.55	-1.40	August 2014
Water	20mm	Copper	-	-	-	-	
Storm	N/A	N/A	-	-	-	-	

Service Connection Location				Sanitary	Storm
Distance from downstream San MH	5332	towards upstream San MH	5333		
Distance from downstream Stm MH		towards upstream Stm MH	-		

Power	Size	Communications	Size	Cable	Size	Gas	Size
BC Hydro	-	Telus	-	Shaw	-	FortisBC	-
Overhead Service		Overhead Service		Overhead Service			

Installed by:	City of Prince George forces	Survey Date:	August 2014
Comments:			

**NOT TO SCALE** The information contained herein is for internal use only.  
Not to be relied on unless confirmed by site inspection and/or investigation.

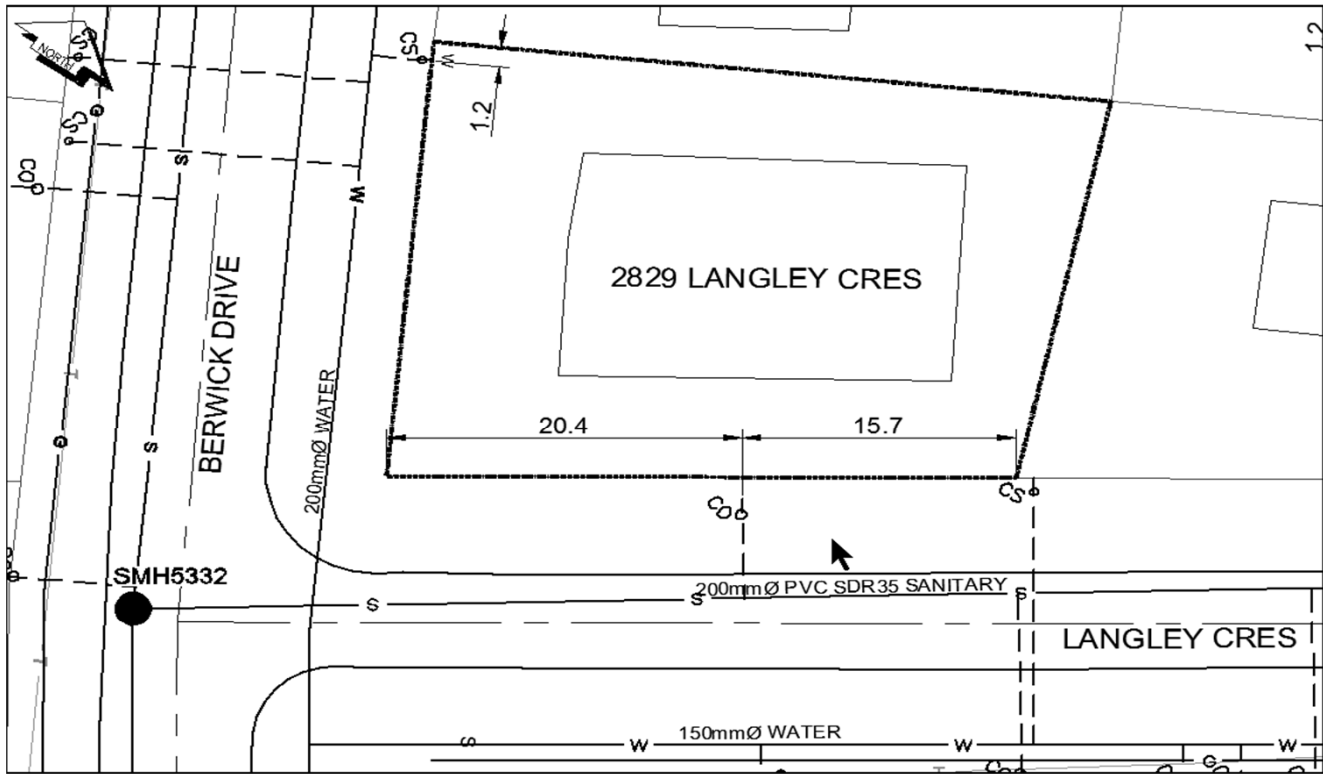

Legend:	CURB STOP	WATER SERVICE	GAS
	CLEAN OUT	SANITARY SERVICE	OVERHEAD POWER & COMMUNICATIONS

**NOT TO SCALE**