



City of Prince George
History Sheet

PID:	008852308
SD/MU:	
WO:	

Civic Address: 2998 Berwick Drive

Legal Description: Lot: 34 District Lot: 4046 Plan: 22626


Service Type	Diameter	Material	Invert Elev at main	Invert Elev at property line	Invert Elev service end	Distance into property	Installation Date
Sanitary	100mm	PVC	744.44	745.52	-	-2.12	August 2014
Water	20mm	Copper	-	-	-	-	
Storm	N/A	N/A	-	-	-	-	

Service Connection Location				Sanitary	Storm
Distance from downstream San MH	5332	towards upstream San MH	5349	94.5m	
Distance from downstream Stm MH	-	towards upstream Stm MH	-		

Power	Size	Communications	Size	Cable	Size	Gas	Size
BC Hydro	-	Telus	-	Shaw	-	FortisBC	-
Overhead Service		Overhead Service		Overhead Service			

Installed by:	City of Prince George forces	Survey Date:	August 2014
Comments:			

NOT TO SCALE The information contained herein is for internal use only.
Not to be relied on unless confirmed by site inspection and/or investigation.

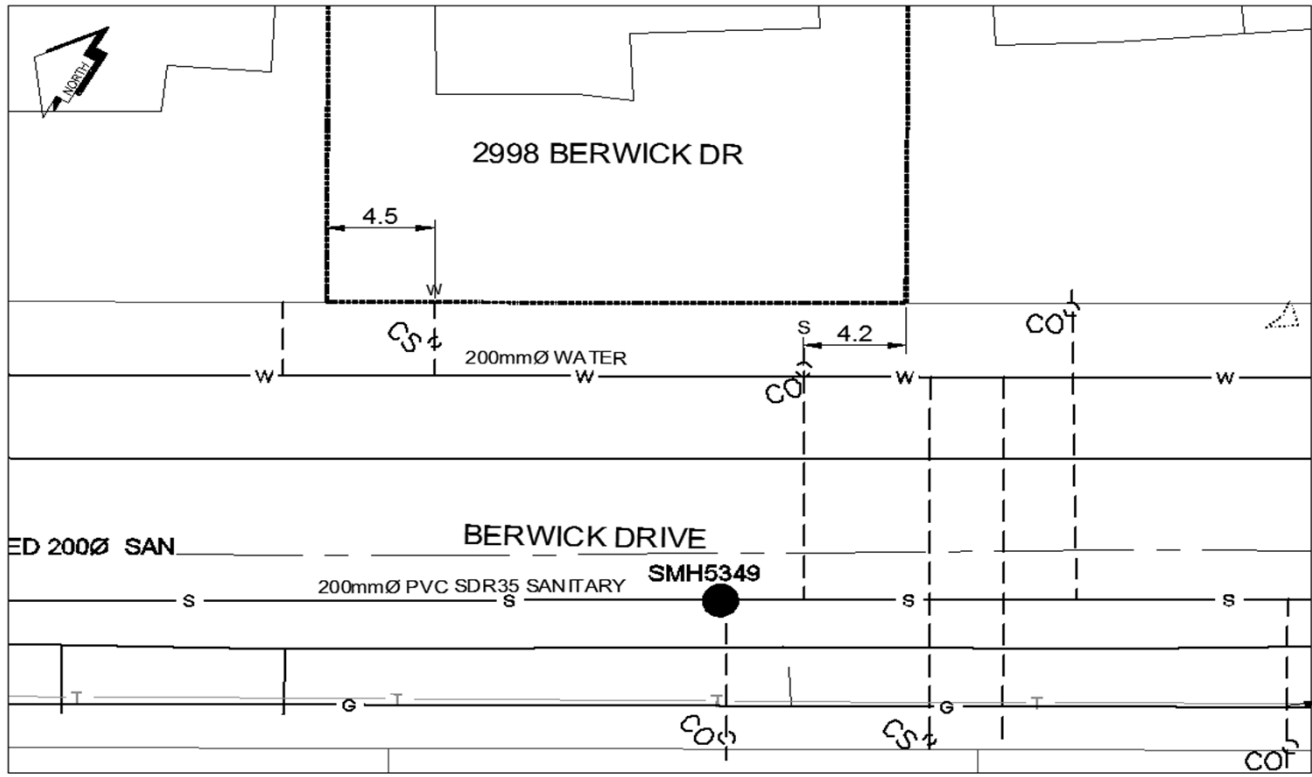

Legend:	CS CURB STOP	--- W WATER SERVICE	--- G GAS
	CO CLEAN OUT	--- S SANITARY SERVICE	--- T OVERHEAD POWER & COMMUNICATIONS

NOT TO SCALE