



City of Prince George
History Sheet

PID:	008852634
SD/MU:	
WO:	

Civic Address: 3028 Dundee Drive

Legal Description: Lot: 54 District Lot: 4046 Plan: 22626


Service Type	Diameter	Material	Invert Elev at main	Invert Elev at property line	Invert Elev service end	Distance into property	Installation Date
Sanitary	100mm	PVC	751.82	-	752.49	-0.70	August 2014
Water	20mm	Copper	-	-	-	-	
Storm	N/A	N/A	-	-	-	-	

Service Connection Location				Sanitary	Storm
Distance from downstream San MH	5334	towards upstream San MH	5335	85.5m	
Distance from downstream Stm MH	-	towards upstream Stm MH	-		

Power	Size	Communications	Size	Cable	Size	Gas	Size
BC Hydro	-	Telus	-	Shaw	-	FortisBC	-
Overhead Service		Overhead Service		Overhead Service			

Installed by:	City of Prince George forces	Survey Date:	August 2014
Comments:			

NOT TO SCALE The information contained herein is for internal use only.
Not to be relied on unless confirmed by site inspection and/or investigation.

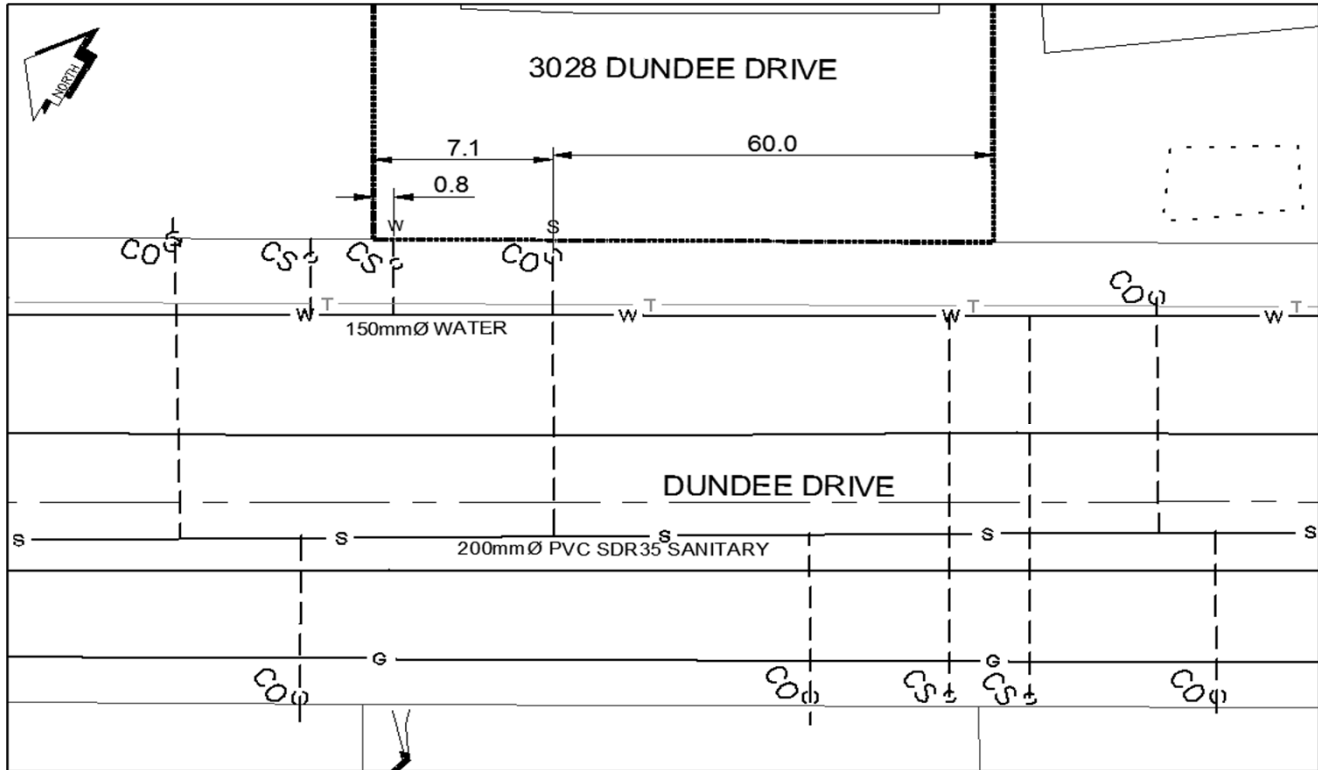

Legend:

CS	CURB STOP	---	W	WATER SERVICE	---	G	GAS
CO	CLEAN OUT	---	S	SANITARY SERVICE	---	T	OVERHEAD POWER & COMMUNICATIONS

NOT TO SCALE