

City of Prince George HISTORY SHEET

SHEET NUMBER 10210

Roll Number 008779261

Legal: LOT'S 60 BLOCK _____ D.L. 2433 PLAN 22464

Address: 7661 SAPPHIRE PLACE

Sanitary Connection: # _____ SIZE 4' MATERIAL PVC INV. Unknown CONNECTED _____

Water Connection # _____ SIZE 20mm MATERIAL CU METER _____ CONNECTED _____

Storm Connection: # _____ SIZE _____ MATERIAL _____ INV. _____ CONNECTED _____

Cash Receipt No's: WATER _____ SANITARY _____ STORM _____

CURB FROM PROPERTY LINE _____ PAVEMENT WIDTH _____

B.C. HYDRO _____ UNDERGROUND CONNECTION _____


B.C. TELEPHONE _____ UNDERGROUND CONNECTION _____

INLAND GAS _____

Information Sheets: _____

Comments: _____

THE INFORMATION CONTAINED HEREIN IS FOR INTERNAL
USE ONLY. NOT TO BE RELIED UPON UNLESS CONFIRMED
BY SITE INSPECTION AND/OR INVESTIGATION.

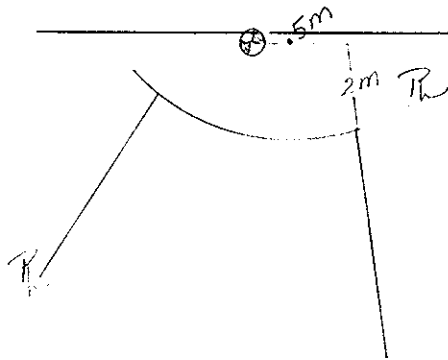

SITE

PLAN

N.T.S.

