

**City of Prince George
HISTORY SHEET**

008895309

SHEET NUMBER

PID #

Legal: LOTS B BLOCK D.L. 932 PLAN 22396

Address: 2365 QUINCE ST.

Sanitary Connection: # 9682 SIZE 100 mm MATERIAL A.C. INV. CONNECTED

Water Connection: # 9682 SIZE 20 mm MATERIAL CU METER CONNECTED

Storm Connection: # SIZE mm MATERIAL INV. CONNECTED

Cash Receipt No's: WATER SANITARY STORM

CURB FROM PROPERTY LINE 4.877 m PAVEMENT WIDTH 10.363 m

B.C. HYDRO 0/H UNDERGROUND CONNECTION



B.C. TELEPHONE 0/H UNDERGROUND CONNECTION

INLAND GAS 3.657 m FROM R.

Information Sheets:

Comments: WITH THAW WIRE.

**THE INFORMATION CONTAINED HEREIN IS FOR INTERNAL USE ONLY.
NOT TO BE RELIED UPON UNLESS CONFIRMED BY SITE INSPECTION AND/OR INVESTIGATION**

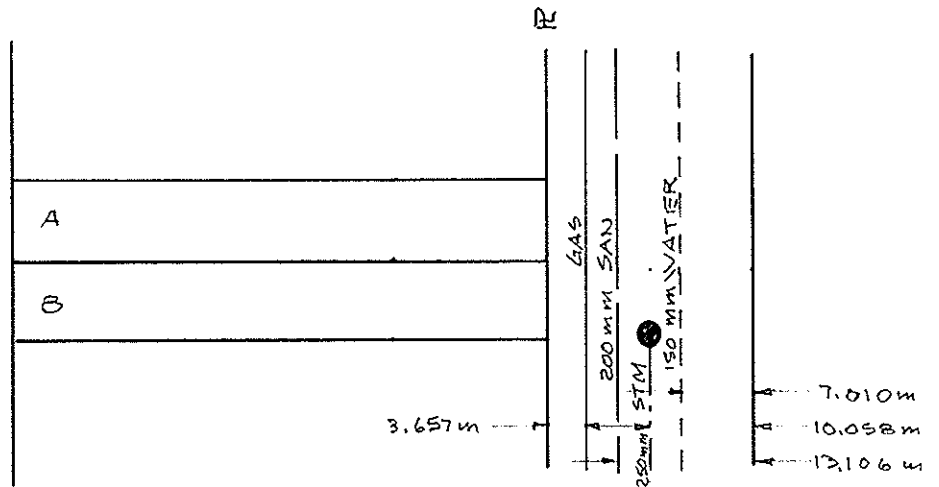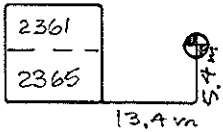

QUINCE ST.