

City of Prince George HISTORY SHEET

SHEET NUMBER 10265 Roll Number 308925996

Legal: LOT'S 85 BLOCK 2433 D.L. 2433 PLAN 22.369

Address: 1058 DIAMOND DRIVE

Sanitary Connection: # _____ SIZE 4" MATERIAL PVC INV. 2/38.7 CONNECTED _____

Water Connection # _____ SIZE 3/4" MATERIAL Copper METER _____ CONNECTED YES

Storm Connection: # _____ SIZE _____ MATERIAL _____ INV. _____ CONNECTED _____

Cash Receipt No's: WATER _____ SANITARY _____ STORM _____

CURB FROM PROPERTY LINE _____ PAVEMENT WIDTH _____

B.C. HYDRO _____ UNDERGROUND CONNECTION _____


B.C. TELEPHONE _____ UNDERGROUND CONNECTION _____

INLAND GAS _____

Information Sheets: _____

Comments: _____

SITE PLAN N.T.S.

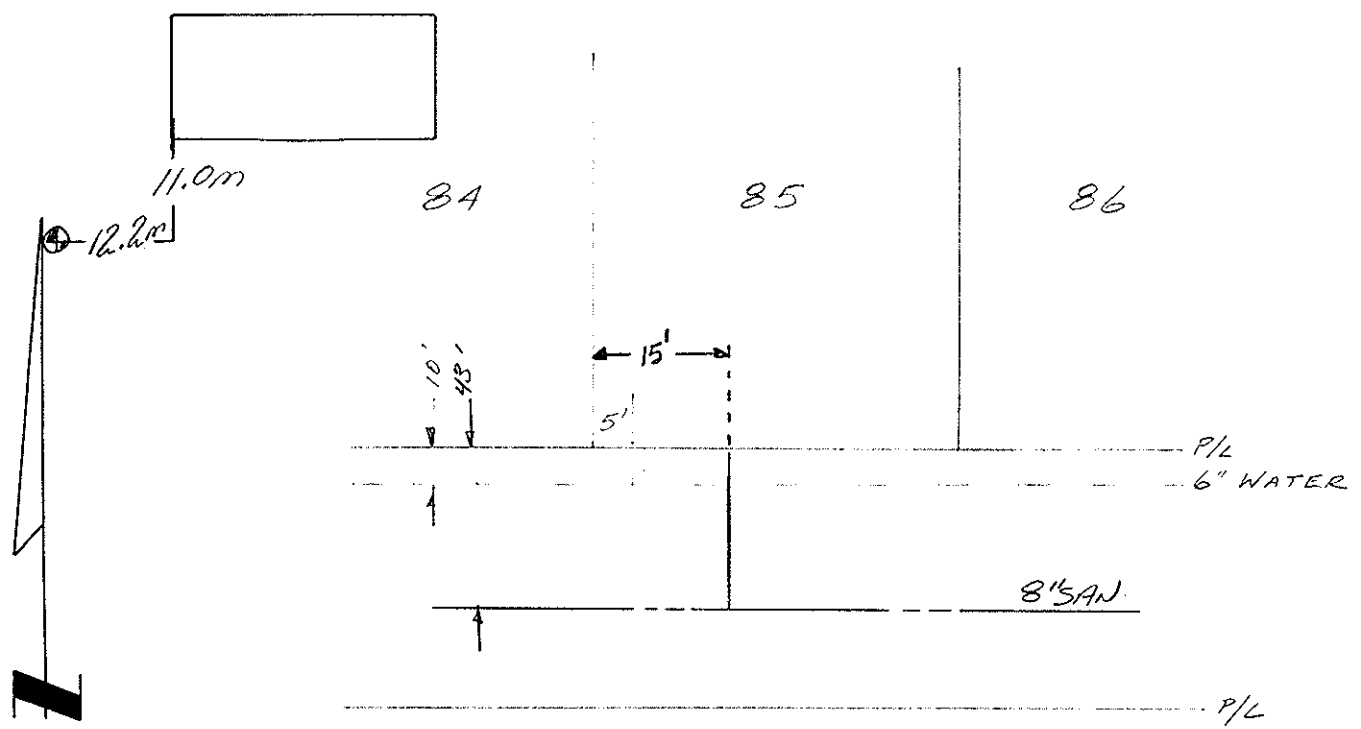

DIAMOND DR.