

City of Prince George HISTORY SHEET

SHEET NUMBER 10254

Roll Number 008926263

Legal: LOT'S 96 BLOCK 2433 D.L. 2433 PLAN 22369

Address: 3976 DIAMOND DRIVE

Sanitary Connection: # _____ SIZE 4" MATERIAL PVC INV. 2414.14 CONNECTED

Water Connection # _____ SIZE _____ MATERIAL _____ METER _____ CONNECTED

Storm Connection: # _____ SIZE _____ MATERIAL _____ INV. _____ CONNECTED

Cash Receipt No's: WATER _____ SANITARY _____ STORM _____

CURB FROM PROPERTY LINE _____ PAVEMENT WIDTH _____


B.C. HYDRO _____ UNDERGROUND CONNECTION

B.C. TELEPHONE _____ UNDERGROUND CONNECTION

INLAND GAS _____

Information Sheets: _____

Comments: _____

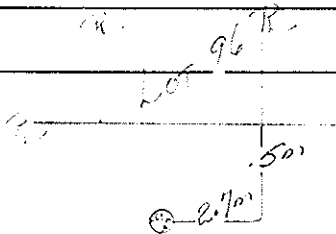

SITE PLAN N.T.S.

