

City of Prince George HISTORY SHEET

SHEET NUMBER **Nº 0090** Roll Number **008928444**

Legal: LOT'S **113** BLOCK **D.L. 2433** PLAN **22369**

Address: **3987. DIAMOND DR**

Sanitary Connection: # **4"** MATERIAL **PVC.** INV. **2420.6** CONNECTED

Water Connection # **3/4"** MATERIAL **CU.** METER CONNECTED

Storm Connection: # **SIZE** MATERIAL INV. CONNECTED

Cash Receipt No's: WATER SANITARY STORM

CURB FROM PROPERTY LINE PAVEMENT WIDTH


B.C. HYDRO UNDERGROUND CONNECTION

B.C. TELEPHONE UNDERGROUND CONNECTION

INLAND GAS

Information Sheets:

Comments: *The City of Prince George does not represent or guarantee that information contained in this document is accurate or reliable and any person who relies on information in this document does so at his own risk.*

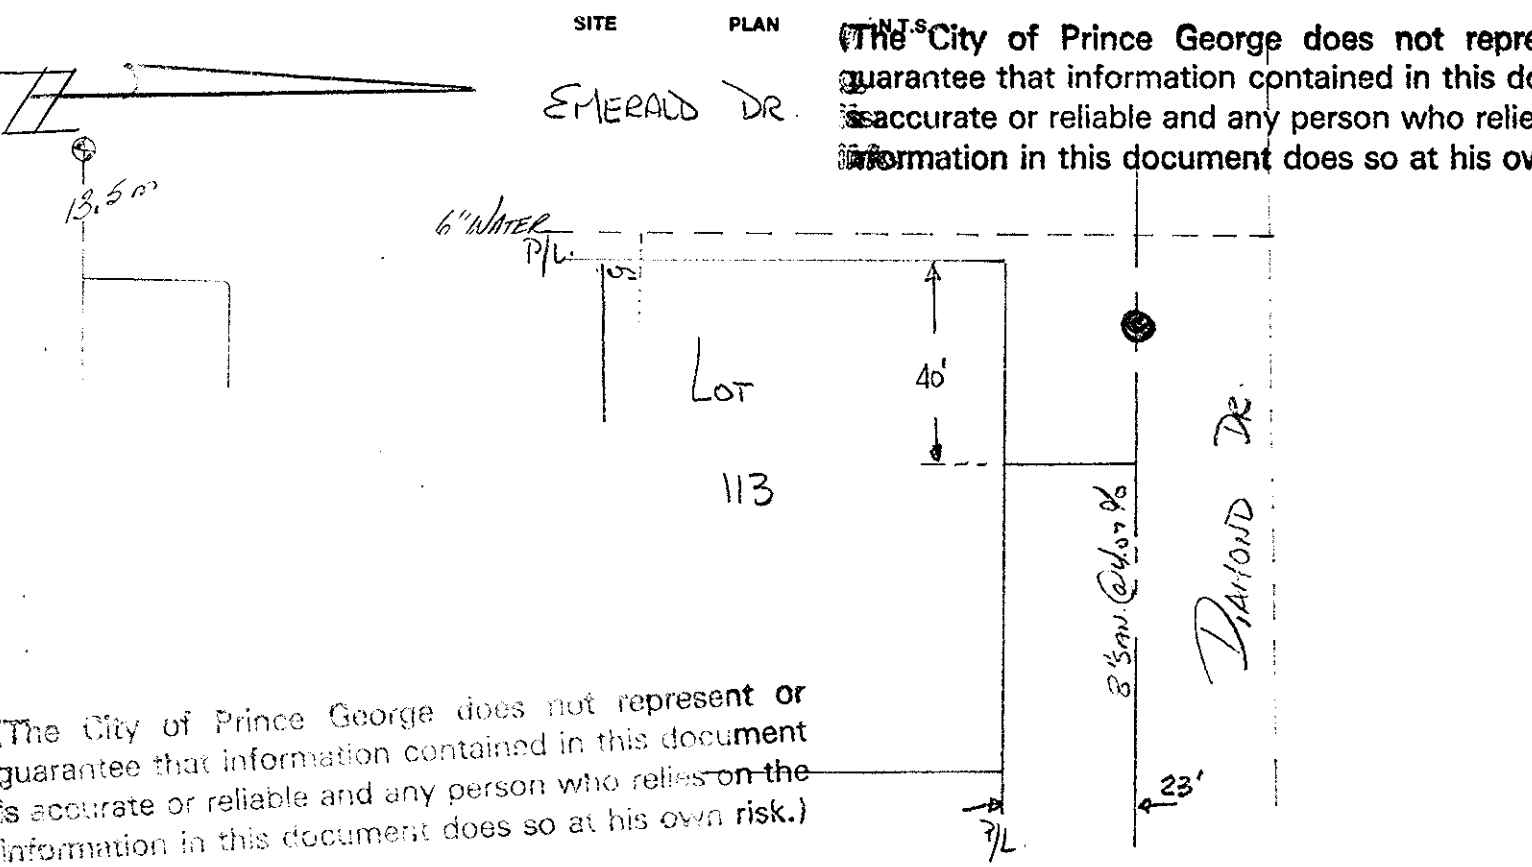

(The City of Prince George does not represent or guarantee that information contained in this document is accurate or reliable and any person who relies on the information in this document does so at his own risk.)