

# City of Prince George HISTORY SHEET

008969/62

SHEET NUMBER **Nº 1057** Roll Number **183**

Legal: LOT'S **17-18** BLOCK **32** D.L. **1429** PLAN **646**

Address: **1148 HARPER ST.**

Sanitary Connection: # **1262** SIZE MATERIAL INV. CONNECTED

Water Connection # **1544** SIZE **19mm** MATERIAL **COPPER** METER CONNECTED

Storm Connection: # SIZE MATERIAL INV. CONNECTED

Cash Receipt No's: WATER SANITARY STORM

CURB FROM PROPERTY LINE PAVEMENT WIDTH

B.C. HYDRO UNDERGROUND CONNECTION

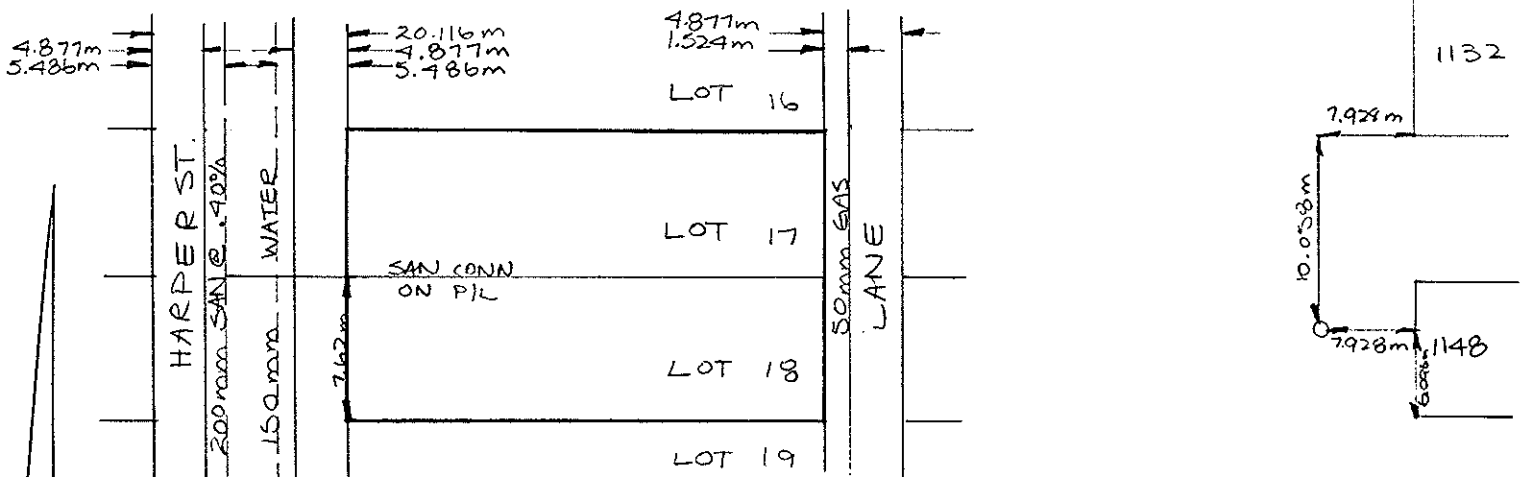
B.C. TELEPHONE UNDERGROUND CONNECTION

INLAND GAS

Information Sheets:

Comments:

SITE PLAN N.T.S.



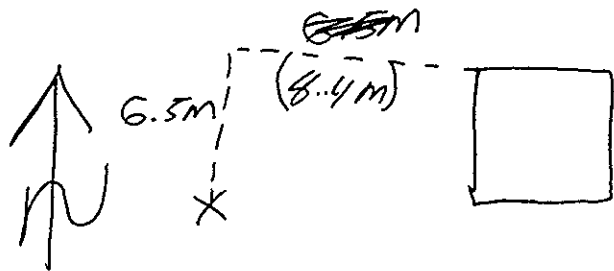
# REPORT TO RECORDS

## WATER SERVICE INFORMATION

Lot No. \_\_\_\_\_ Block \_\_\_\_\_ D.L. \_\_\_\_\_

Address 1148 Harper STSize of Connection ☐ 1/2" ☒ 3/4" ☐ Other \_\_\_\_\_Type of Connection ☒ Copper ☐ IronThaw Wire ☒ Yes ☐ No

### LOCATION SKETCH

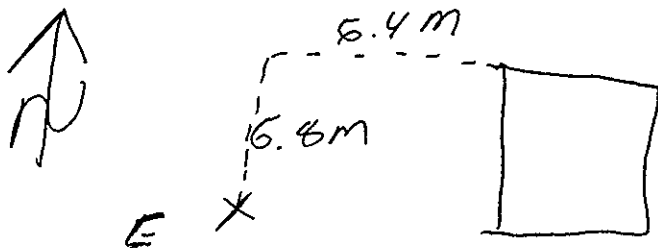
Field Location By JH Date MAR 20/96

Checked by: \_\_\_\_\_

**REPORT TO RECORDS**

## SEWER SERVICE INFORMATION

Lot No. \_\_\_\_\_ Block \_\_\_\_\_ D.L. \_\_\_\_\_

Address 11 1/8 Harper STSize of Connection ☒ 100mm ☐ 150mm ☐ 200mm ☐ Other \_\_\_\_\_Type of Connection ☐ Transite ☒ PVC ☐ Other \_\_\_\_\_Type of Cap ☐ Transite ☒ Cast Iron**LOCATION SKETCH**

S

Field Location By jlh Date MAR 20/96

Checked by Foreman - Sewer Division \_\_\_\_\_