

58969/67  
183

Roll Number 183

**Address:** 1148 HARPER ST.

Water Connection	# 1544	SIZE 19mm	MATERIAL COPPER	METER	CONNECTED
------------------	--------	-----------	-----------------	-------	-----------

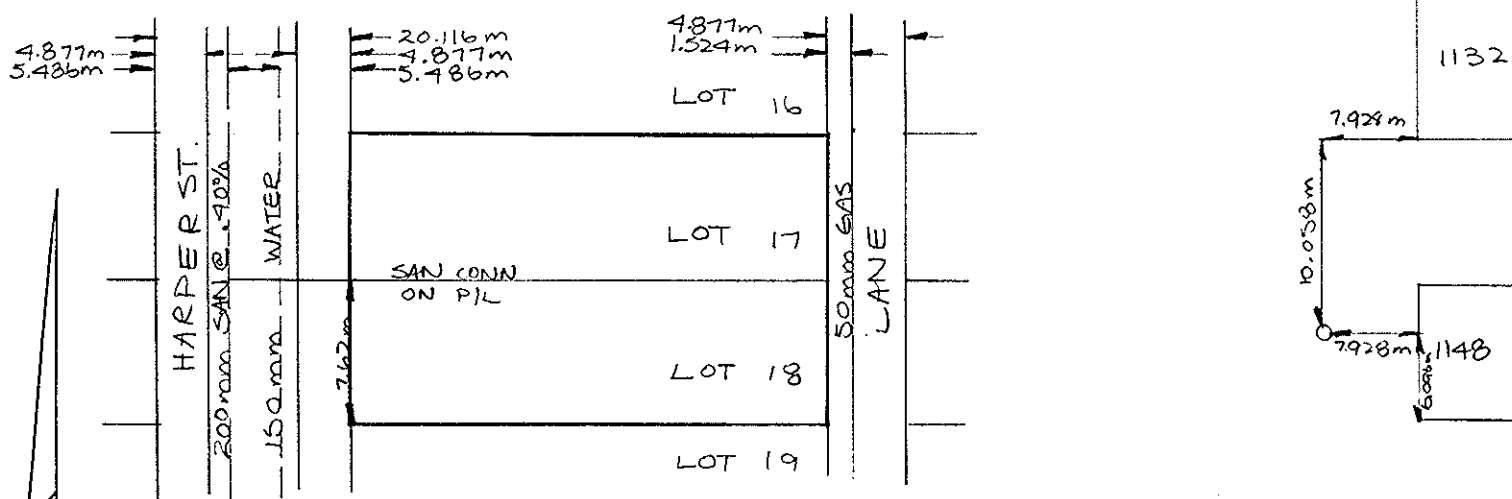
**Cash Receipt No's:** WATER SANITARY STORM

B.C. TELEPHONE	UNDERGROUND CONNECTION
1	
2	
### Information Sheets:

**Comments:**

SITE	PLAN	N.T.S.
------	------	--------



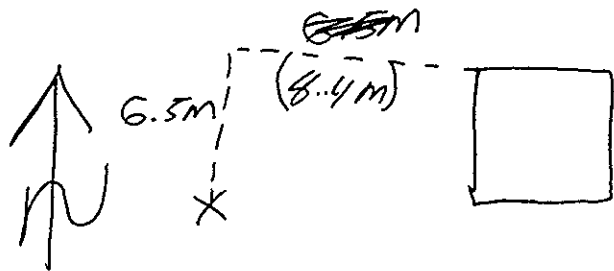
# REPORT TO RECORDS

## WATER SERVICE INFORMATION

Lot No. \_\_\_\_\_ Block \_\_\_\_\_ D.L. \_\_\_\_\_

Address 1148 Harper STSize of Connection ☐ 1/2" ☒ 3/4" ☐ Other \_\_\_\_\_Type of Connection ☒ Copper ☐ IronThaw Wire ☒ Yes ☐ No

### LOCATION SKETCH

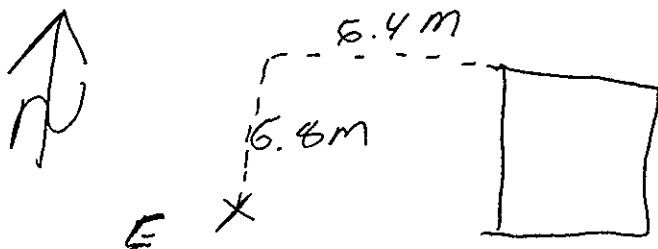
Field Location By JH Date MAR 20/96

Checked by: \_\_\_\_\_

**REPORT TO RECORDS**

## SEWER SERVICE INFORMATION

Lot No. \_\_\_\_\_ Block \_\_\_\_\_ D.L. \_\_\_\_\_

Address 11 1/8 Harper STSize of Connection ☒ 100mm ☐ 150mm ☐ 200mm ☐ Other \_\_\_\_\_Type of Connection ☐ Transite ☒ PVC ☐ Other \_\_\_\_\_Type of Cap ☐ Transite ☒ Cast Iron**LOCATION SKETCH**

5

Field Location By jlh Date MAR 20/96

Checked by Foreman - Sewer Division \_\_\_\_\_