

# City of Prince George HISTORY SHEET

SHEET NUMBER

Roll Number 008990 921

Legal: LOT'S C BLOCK D.L. 2507 PLAN 2224A

Address: 4235 QUENTIN AVE.

Sanitary Connection: # 8404 SIZE 100mm MATERIAL A.C. INV. CONNECTED

Water Connection # 8404 SIZE 20mm MATERIAL CU. METER CONNECTED

Storm Connection: # SIZE MATERIAL INV. CONNECTED

Cash Receipt No's: WATER SANITARY STORM

CURB FROM PROPERTY LINE 4.877 PAVEMENT WIDTH 10.363m

B.C. HYDRO U/G UNDERGROUND CONNECTION


B.C. TELEPHONE U/G UNDERGROUND CONNECTION

INLAND GAS AS SHOWN

Information Sheets:

Comments:

**THE INFORMATION CONTAINED HEREIN IS FOR INTERNAL USE ONLY.  
NOT TO BE RELIED UPON UNLESS CONFIRMED BY SITE INSPECTION AND/OR INVESTIGATION**

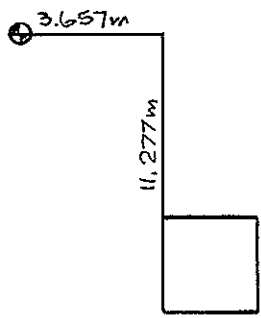

QUENTIN AVE.

