
## City of Prince George HISTORY SHEET

004042016

FM **Roll Number** SHEET NUMBER 22108 32 Legal: LOT'S BLOCK 4554 LAW AVE Address: **Sanitary Connection:** INV. CONNECTED SIZE MATERIAL CONNECTED **Water Connection** METER SIZE CONNECTED **Storm Connection:** INV. SIZE MATERIAL STORM Cash Receipt No's: SANITARY WATER PAVEMENT WIDTH CURB FROM PROPERTY LINE UNDERGROUND CONNECTION B.C. HYDRO UNDERGROUND CONNECTION B.C. TELEPHONE INLAND GAS **Information Sheets:** 

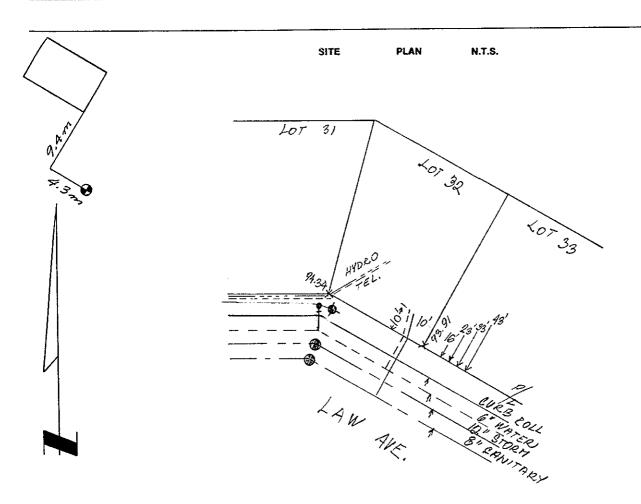

**Comments:**