



City of Prince George History Sheet

PID:	009054570
SD/MU:	
WO:	

Civic Address: 490 Carney St

Legal Description: Lot: A District Lot: 343 Plan: 22100


Service Type	Diameter (mm)	Material	Invert Elev at main (m)	Invert Elev at property line (m)	Invert Elev at service end (m)	Distance into property (m)	Installation Date
Sanitary	100mm	AC	-	587.37	1.62	-	December 1957
Water	40mm	Copper	-	-	-	-	December 1964
Storm	150mm	AC	-	587.59	1.40	-	December 1964

Service Connection Location				Sanitary (m)	Storm (m)
Distance from downstream San MH	1640	towards upstream San MH	978	-	
150mm Storm service connected to Stm MH736					

Power	Size	Communications	Size	Cable	Size	Gas	Size
BC Hydro	-	Telus	-	Shaw	-	FortisBC	-
Underground Service		Underground Service		Underground Service			

Installed by:	Survey Date:	-
Comments:	Decommissioning of water services confirmed May 2018 by UTOPS	

NOT TO SCALE The information contained herein is for internal use only.
Not to be relied on unless confirmed by site inspection and/or investigation.

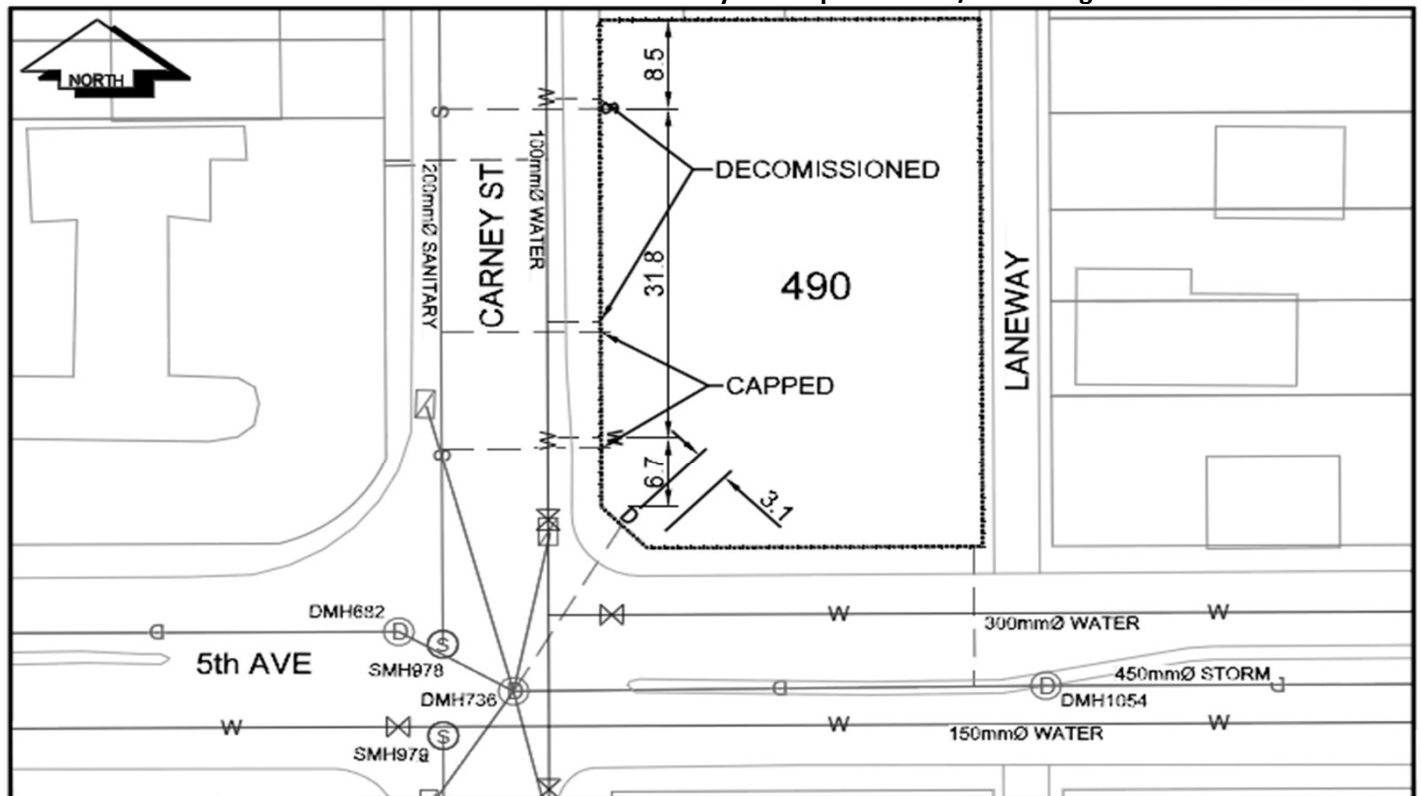

CS ^o CURB STOP	--- WATER SERVICE	--- STORM SERVICE
CO ^o CLEAN OUT	--- SANITARY SERVICE	--- GAS
⊗ WATER VALVE	⊗ FIRE HYDRANT	--- ENCUMBRANCE

NOT TO SCALE