
## City of Prince George HISTORY SHEET

SHEET NUMBER PID# 009/03 4/06				
Legal: LOTS 16	BLOCK D.L. 26	508 PLAN 20043		
Address: 4897	FIRST AVE.			
Sanitary Connection: # 7561	SIZE LOO mm MATERIAL A, C,	INV. CONNECTED		
Water Connection: # 758	SIZE ZO MM MATERIAL CU,	METER CONNECTED		
Storm Connection: #	SIZE mm MATERIAL	INV. CONNECTED		
Cash Receipt No's: WATER	sanitary 9	STORM		
CURB FROM PROPERTY LINE 5,791 M		PAVEMENT WIDTH 12,801 W		
B.C. HYDRO U/G	UNDERGROUND CONNECT	ION		
B.C. TELEPHONE U/C1	' UNDERGROUND CONNECT	ION		
INLAND GAS 3,048 M FROM	R.			
Information Sheets:				
Comments:				

## THE INFORMATION CONTAINED HEREIN IS FOR INTERNAL USE ONLY. NOT TO BE RELIED UPON UNLESS CONFIRMED BY SITE INSPECTION AND/OR INVESTIGATION

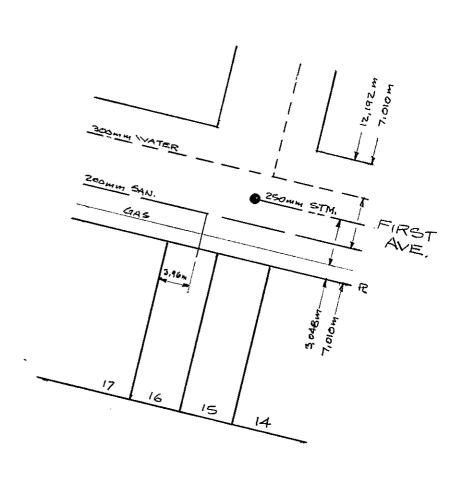

CITY PUBLIC WORKS DEPT. OUT 105 YUF

## REPORT TO RECORDS 2 1987

WATER SERVICE INFORMATION

Lot No	<b>51</b>			71 - 4	
	Block	10-	D.L 1	. 2608	<del></del>
Address	397 /	137 H	VENUE	الح	<del></del>
Size of Connection	□ ½″ □	¾″ □ 0	ther		
Type of Connection	☐ Copper	☐ Iron	•		
Thaw Wire	Yes	□ No	12 2	0043	
LOCATION SKETCI					
				\	
				Nor	H
. <b>-</b>	<del></del>	***************************************	Rol	Nort 8m	′′
		•			
		°43.	<b>.v</b>		
		رەك ر	m	,	
ield Location By	tilobo	nd	Date 4	June 9	<u>1987</u>
				//	
hecked by:			▼		•