
## City of Prince George Lot History Sheet

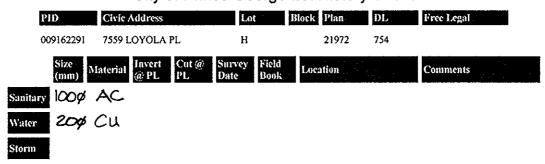

Accuracy Not Guaranteed Unless Confirmed By Site Inspection and/or Investigation. Sketch is Oriented North (NTS)

