

City of Prince George  
HISTORY SHEET

SHEET NUMBER **7716** Roll Number **009266397**

Legal: LOT'S **17** BLOCK D.L. **754** PLAN **21798**

Address: **7535 JEAN DE BREBEUF**

Sanitary Connection: # SIZE **4"  $\phi$**  MATERIAL **A.C.** INV. CONNECTED

Water Connection # SIZE **3/4"  $\phi$**  MATERIAL **CU.** METER CONNECTED

Storm Connection: # SIZE MATERIAL INV. CONNECTED

Cash Receipt No's: WATER SANITARY STORM

CURB FROM PROPERTY LINE **18'** PAVEMENT WIDTH **30'**

B.C. HYDRO UNDERGROUND CONNECTION

B.C. TELEPHONE UNDERGROUND CONNECTION


INLAND GAS

Information Sheets:


Comments:

SITE PLAN N.T.S.

Jean de Brebeuf Cres.

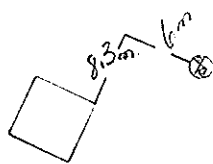

Lot 18

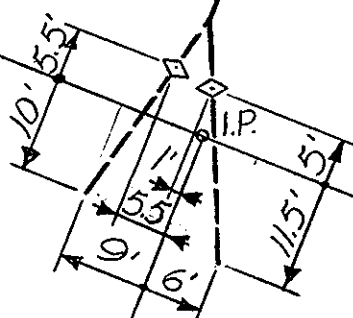

Lot 17

