



# City of Prince George History Sheet

|        |           |
|--------|-----------|
| PID:   | 012990612 |
|        | 009301836 |
|        | 009301861 |
|        | 009301887 |
| SD/MU: |           |
| WO:    |           |

Civic Address: 1505 5th Ave

Legal Description: Lot: 9 - 12 Block: 161 District Lot: 343 Plan: 1268


| Service Type     | Diameter (mm) | Material | Invert Elev at main (m) | Invert Elev at property line (m) | Invert Elev at service end (m) | Distance into property (m) | Installation Date |
|------------------|---------------|----------|-------------------------|----------------------------------|--------------------------------|----------------------------|-------------------|
| Sanitary (Lot 9) | 100mm         | PVC      | -                       | -                                | -                              | -                          | January 1956      |
| Water (PCL A)    | 100mm         | PVC      | -                       | -                                | -                              | -                          | January 1957      |
| Storm (Lot 12)   | 150mm         | PVC      | -                       | -                                | -                              | -                          | January 1973      |

| Service Connection Location                  |      |                         |      | Sanitary (m) | Storm (m) |
|--|------|-------------------------|------|--------------|-----------|
| Distance from downstream San MH              | 3095 | towards upstream San MH | 2000 | 57.60        |           |
| 150mm Storm service connected to Stm MH 3009 |      |                         |      |              |           |

| Power            | Size | Communications   | Size | Cable            | Size | Gas      | Size |
|------------------|------|------------------|------|------------------|------|----------|------|
| BC Hydro         | -    | Telus            | -    | Shaw             | -    | FortisBC | -    |
| Overhead Service |      | Overhead Service |      | Overhead Service |      |          |      |

|               |              |   |
|---------------|--------------|---|
| Installed by: | Survey Date: | - |
| Comments:     |              |   |
|               |              |   |
|               |              |   |

**NOT TO SCALE** The information contained herein is for internal use only.  
Not to be relied on unless confirmed by site inspection and/or investigation.

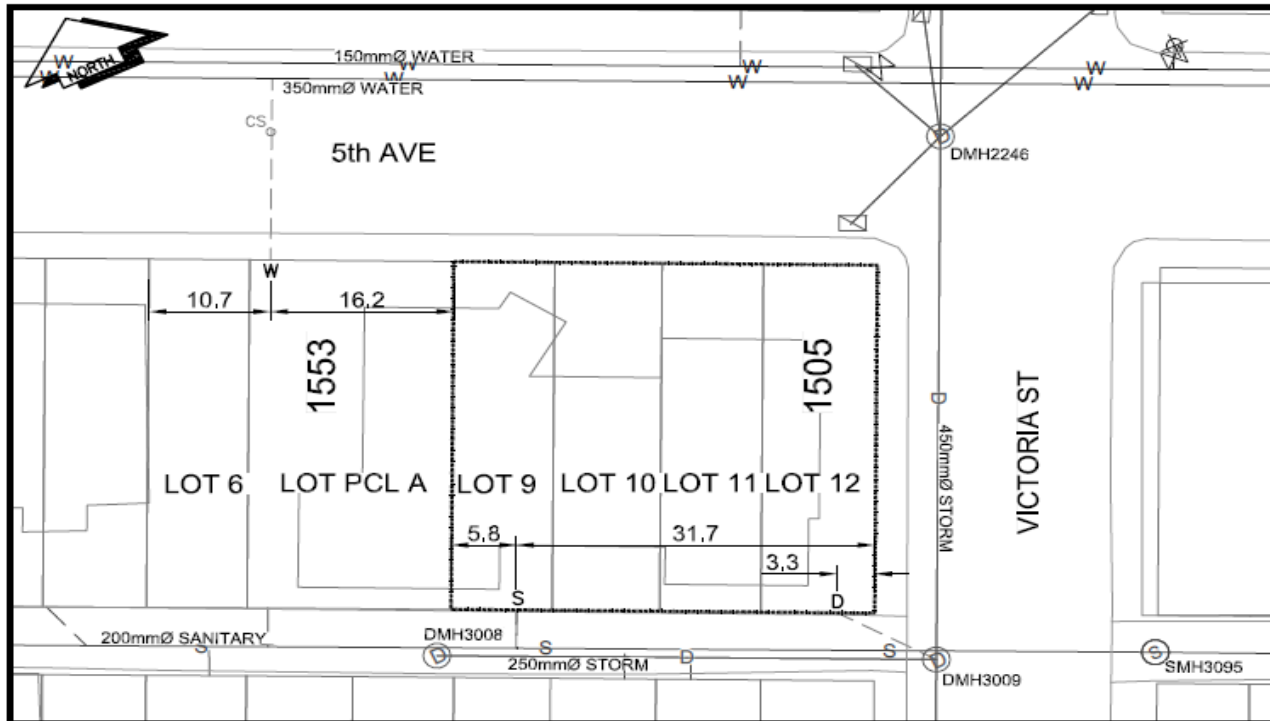

|         |              |                        |                     |
|---------|--------------|------------------------|---------------------|
| LEGEND: | CS CURB STOP | --- WATER SERVICE      | --- D STORM SERVICE |
|         | CO CLEAN OUT | --- S SANITARY SERVICE | --- G GAS           |

**NOT TO SCALE**