
City of Prince George HISTORY SHEET

SHEET NUMBER		Roll Number 609367249		r 509307249
Legal: LOT'S A	BLOCK	D.L. 2 5	507 PL	an 21680
Address: 4260 Qu	JENTIN	AVE.		
Sanitary Connection: # 8395	SIZE 100 MM	MATERIAL A.C.	INV.	CONNECTED
Water Connection # 8395	SIZE 20 MM	MATERIAL CU	METER	CONNECTED
Storm Connection:	SIZE	MATERIAL	INV.	CONNECTED
Cash Receipt No's: WATER	s	ANITARY	STORM	
CURB FROM PROPERTY LINE 4, 877 M			PAVEMENT WIDTH	10,363 m
B.C. HYDRO		UNDERGROUND CONNECT	TION	
B.C. TELEPHONE		UNDERGROUND CONNECT	rion	
INLAND GAS AS SHOWN				
Information Sheets:				
Comments:				

THE INFORMATION CONTAINED HEREIN IS FOR INTERNAL USE ONLY. NOT TO BE RELIED UPON UNLESS CONFIRMED BY SITE INSPECTION AND/OR INVESTIGATION

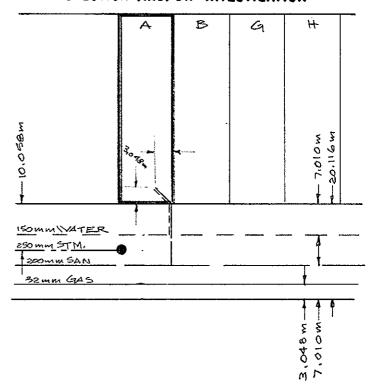

OUENTIN AVE.