



City of Prince George History Sheet

PID:	009307419-
MU:	100152
WO:	

Civic Address: 2233 Sussex Lane

Legal Description: Lot: A District Lot: 4046 Plan: 21681


Service Type	Diameter (mm)	Material	Invert Elev at main (m)	Invert Elev at property line (m)	Invert Elev at service end (m)	Distance into property (m)	Installation Date
Sanitary	150mm	PVC	-	-	-	-	January 1977
Water	150mm	PVC	-	-	-	-	Aug 2002
Storm	N/A	N/A	-	-	-	-	

Service Connection Location	Sanitary (m)	Storm (m)
150mm Sanitary service connected to San MH on McKenney Cres	-	
Distance from downstream Stm MH - towards upstream Stm MH -		

Power	Size	Communications	Size	Cable	Size	Gas	Size
BC Hydro	-	Telus	-	Shaw	-	FortisBC	-
Underground Service		Underground Service		Underground Service			

Installed by:	Survey Date:	-
Comments:		

NOT TO SCALE The information contained herein is for internal use only.
Not to be relied on unless confirmed by site inspection and/or investigation.

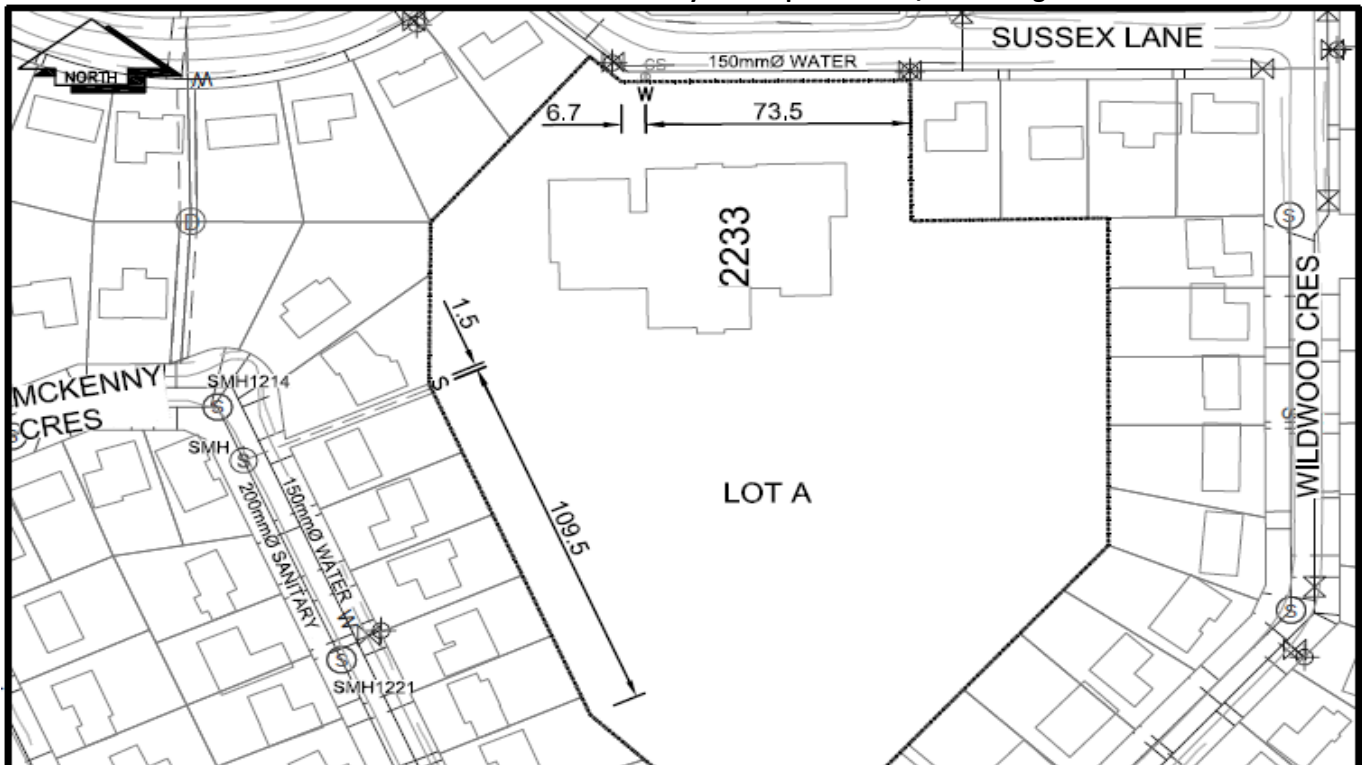

CS CURB STOP	--- W WATER SERVICE	--- S STORM SERVICE
CO CLEAN OUT	--- S SANITARY SERVICE	--- G GAS
WATER VALVE	--- F FIRE HYDRANT	--- E ENCUMBRANCE

LEGEND:

NOT TO SCALE