



# City of Prince George History Sheet

PID:	009310991
SD/MU:	
WO:	

Civic Address: 1940 3rd Ave

Legal Description: Lot: A District Lot: 343 Plan: 21694


Service Type	Diameter (mm)	Material	Invert Elev at main (m)	Invert Elev at property line (m)	Invert Elev at service end (m)	Distance into property (m)	Installation Date
Sanitary	Unknown	Unknown	-	-	-	-	-
Water	20mm	Copper	-	-	-	-	January 1961
Storm	N/A	N/A	-	-	-	-	

Service Connection Location						Sanitary (m)	Storm (m)
Distance from downstream San MH			-	towards upstream San MH	-	-	
Distance from downstream Stm MH			-	towards upstream Stm MH	-		

Power	Size	Communications	Size	Cable	Size	Gas	Size
BC Hydro	-	Telus	-	Shaw	-	FortisBC	-
Overhead Service		Overhead Service		Overhead Service			

Installed by:	Survey Date:	-
Comments: Water service location confirmed Nov 2016. Not able to confirm sanitary location.		

**NOT TO SCALE** The information contained herein is for internal use only.  
Not to be relied on unless confirmed by site inspection and/or investigation.

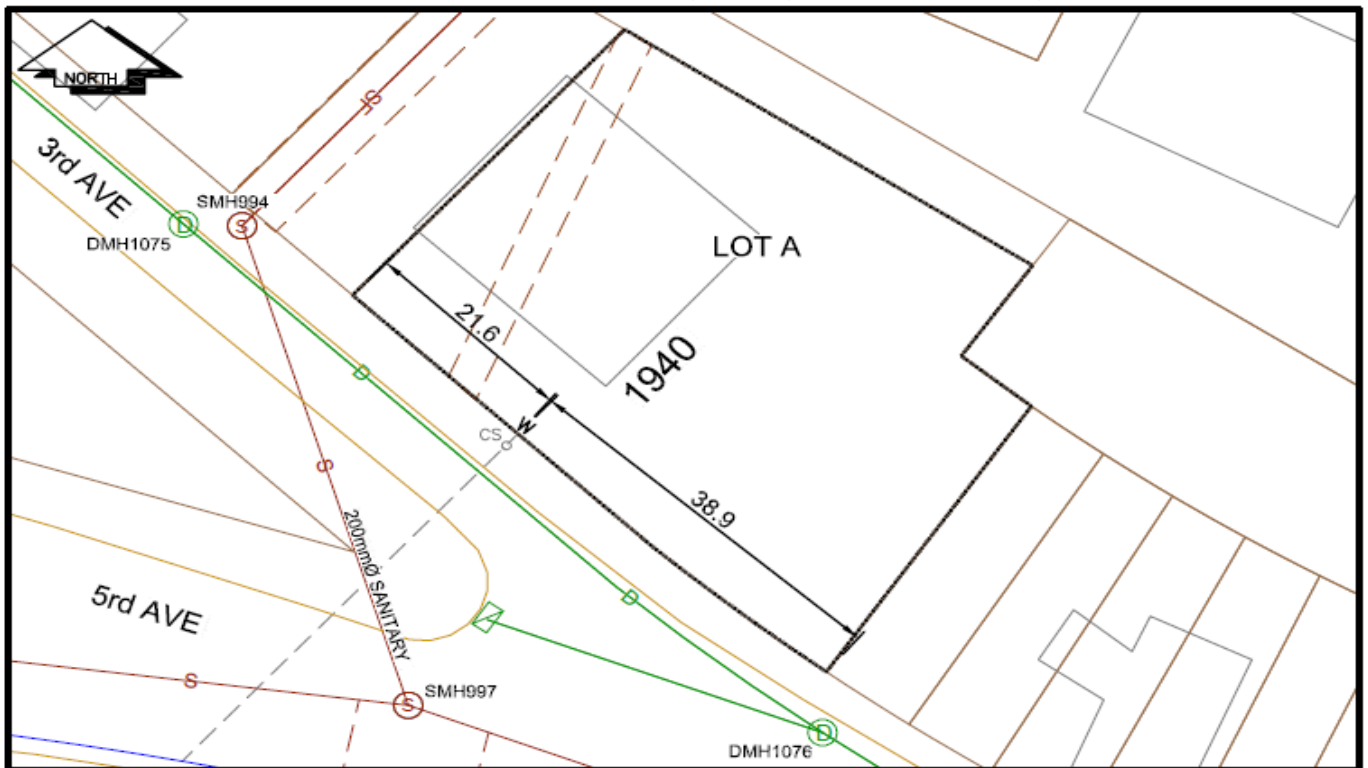

CS <sup>o</sup> CURB STOP	--- WATER SERVICE	--- STORM SERVICE
CO <sup>o</sup> CLEAN OUT	- - - - - S SANITARY SERVICE	- G - GAS

**NOT TO SCALE**