



# City of Prince George History Sheet

PID:	009407511
SD/MU:	
WO:	

Civic Address: 4033 Campbell Ave

Legal Description: Lot: 279 District Lot: 2611 Plan: 21607


Service Type	Diameter (mm)	Material	Invert Elev at main (m)	Invert Elev at property line (m)	Invert Elev at service end (m)	Distance into property (m)	Installation Date
Sanitary	100mm	AC	-	-	2.00	3.00	January 1974
Water	20mm	Copper	-	-	-	3.00	January 1974
Storm	N/A	N/A	-	-	-	-	

Service Connection Location				Sanitary (m)	Storm (m)
Distance from downstream San MH	2943	towards upstream San MH	2947	16.39	
Distance from downstream Stm MH	-	towards upstream Stm MH	-		

Power	Size	Communications	Size	Cable	Size	Gas	Size
BC Hydro	-	Telus	-	Shaw	-	FortisBC	-
Overhead Service		Overhead Service		Overhead Service			

Installed by:	Survey Date:	-
Comments:		

**NOT TO SCALE** The information contained herein is for internal use only.  
Not to be relied on unless confirmed by site inspection and/or investigation.

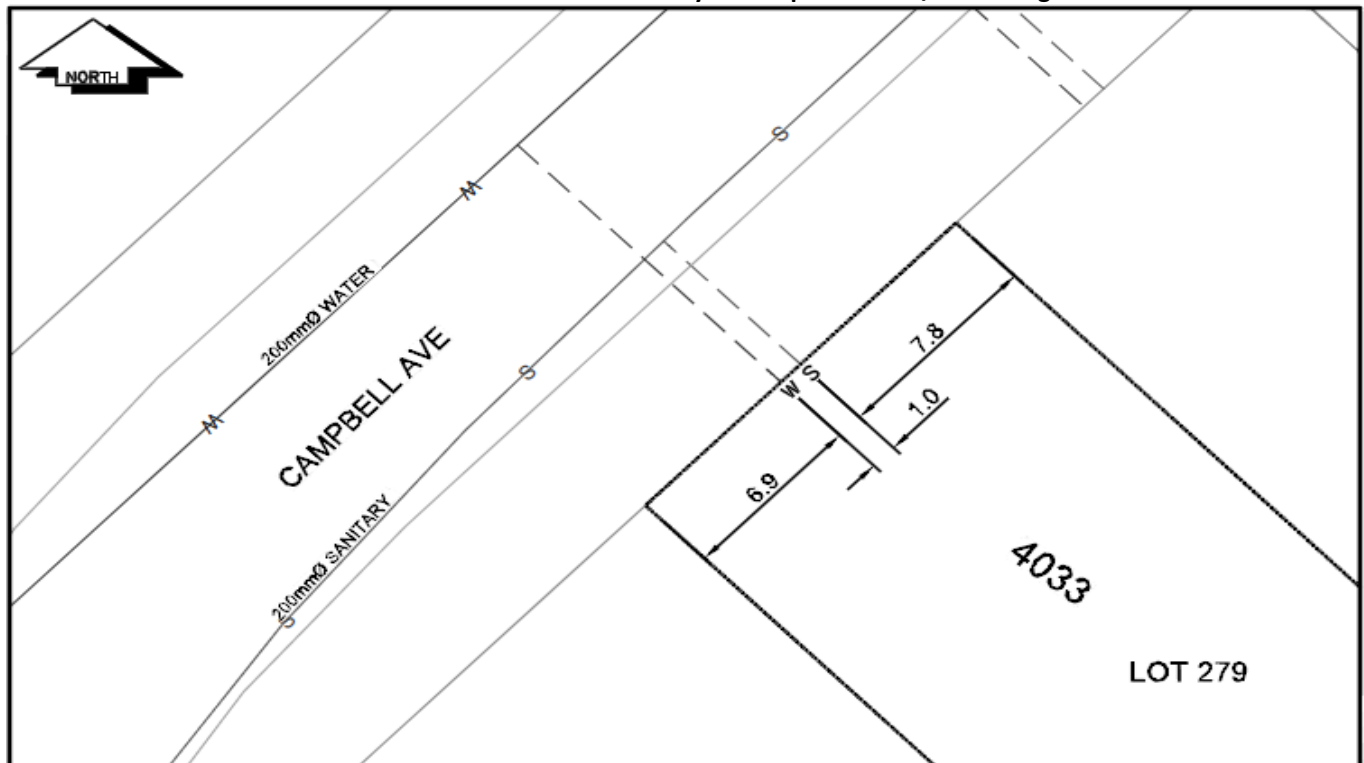

CSO CURB STOP	--- WATER SERVICE	--- STORM SERVICE
COO CLEAN OUT	--- SANITARY SERVICE	--- GAS
WATER VALVE	FIRE HYDRANT	--- ENCUMBERANCE

**NOT TO SCALE**