



# City of Prince George History Sheet

PID:	009407847
SD/MU:	
WO:	

Civic Address: 2498 Foot Street

Legal Description: Lot: 253 District Lot: 2611 Plan: 21607


Service Type	Diameter (mm)	Material	Invert Elev at main (m)	Invert Elev at property line (m)	Invert Elev at service end (m)	Distance into property (m)	Installation Date
Sanitary	100mm	AC	-		-	-	January 1974
Water	20mm	Copper	-	-	-	-	January 1974
Storm	N/A	N/A	-	-	-	-	

Service Connection Location				Sanitary (m)	Storm (m)
Distance from downstream San MH	1180	towards upstream San MH	1176	45.11	
Distance from downstream Stm MH	-	towards upstream Stm MH	-		

Power	Size	Communications	Size	Cable	Size	Gas	Size
BC Hydro	-	Telus	-	Shaw	-	FortisBC	-
Underground Service		Underground Service		Underground Service			

Installed by:	Survey Date:	-
Comments:		

**NOT TO SCALE** The information contained herein is for internal use only.  
Not to be relied on unless confirmed by site inspection and/or investigation.

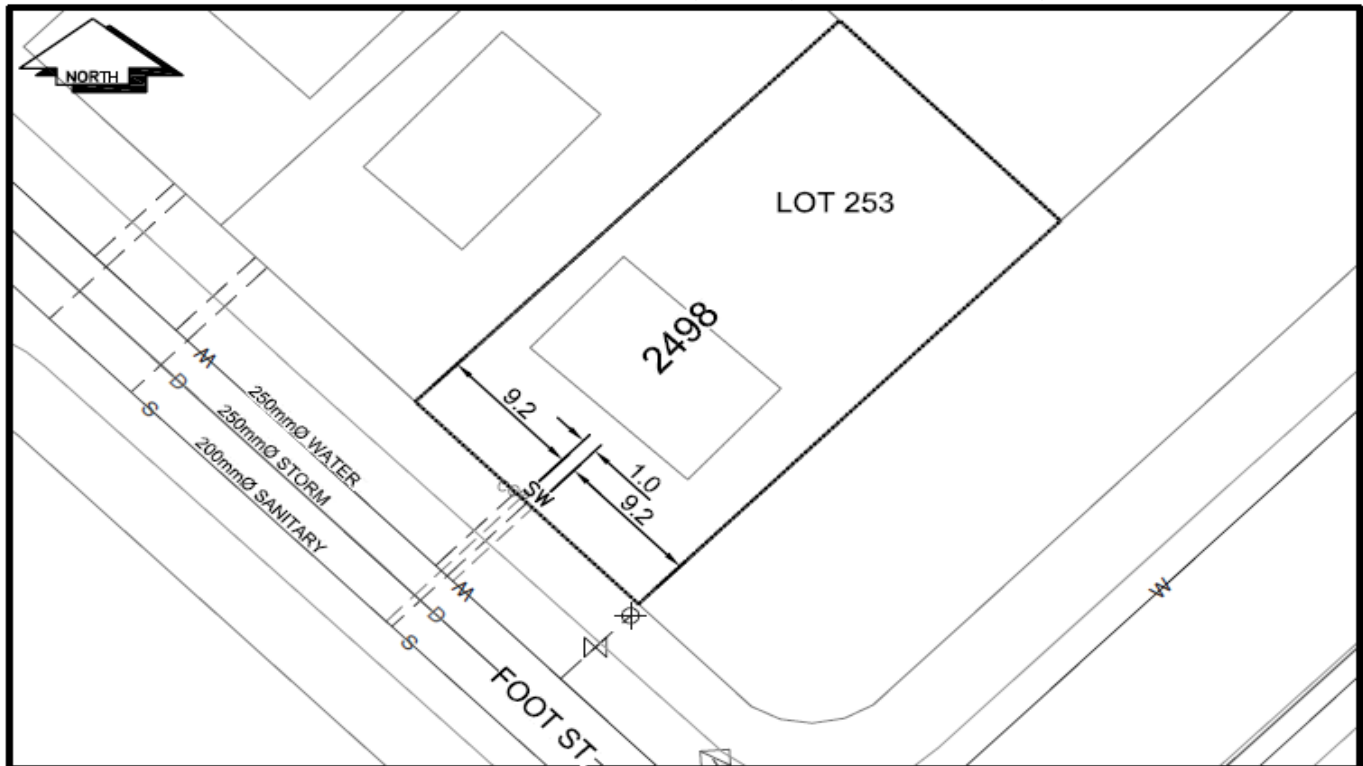

CS <sup>o</sup> CURB STOP	--- W WATER SERVICE	--- S STORM SERVICE
CO <sup>o</sup> CLEAN OUT	--- S SANITARY SERVICE	--- G GAS
⊕ WATER VALVE	⊕ FIRE HYDRANT	--- ENCUMBERANCE

**NOT TO SCALE**