



# City of Prince George History Sheet

PID:	009444262
SD/MU:	
WO:	5001398

Civic Address: 2275 Olds St

Legal Description: Lot: 27 District Lot: 2611 Plan: 21607


Service Type	Diameter (mm)	Material	Invert Elev at main (m)	Invert Elev at property line (m)	Invert Elev at service end (m)	Distance into property (m)	Installation Date
Sanitary	100mm	PVC	601.06	601.07	-	-	December 1973
Water	20mm	Copper	600.43	600.97	-	-	December 1973
Storm	N/A	N/A	-	-	-	-	

Service Connection Location				Sanitary (m)	Storm (m)
Distance from downstream San MH	2935	towards upstream San MH	2930	59.50	
Distance from downstream Stm MH	-	towards upstream Stm MH	-		

Power	Size	Communications	Size	Cable	Size	Gas	Size
BC Hydro	-	Telus	-	Shaw	-	FortisBC	-
Underground Service		Underground Service		Underground Service			

Installed by:	City of Prince George forces	Survey Date:	-
Comments:	Water service repair completed December 2015		

**NOT TO SCALE** The information contained herein is for internal use only.  
Not to be relied on unless confirmed by site inspection and/or investigation.

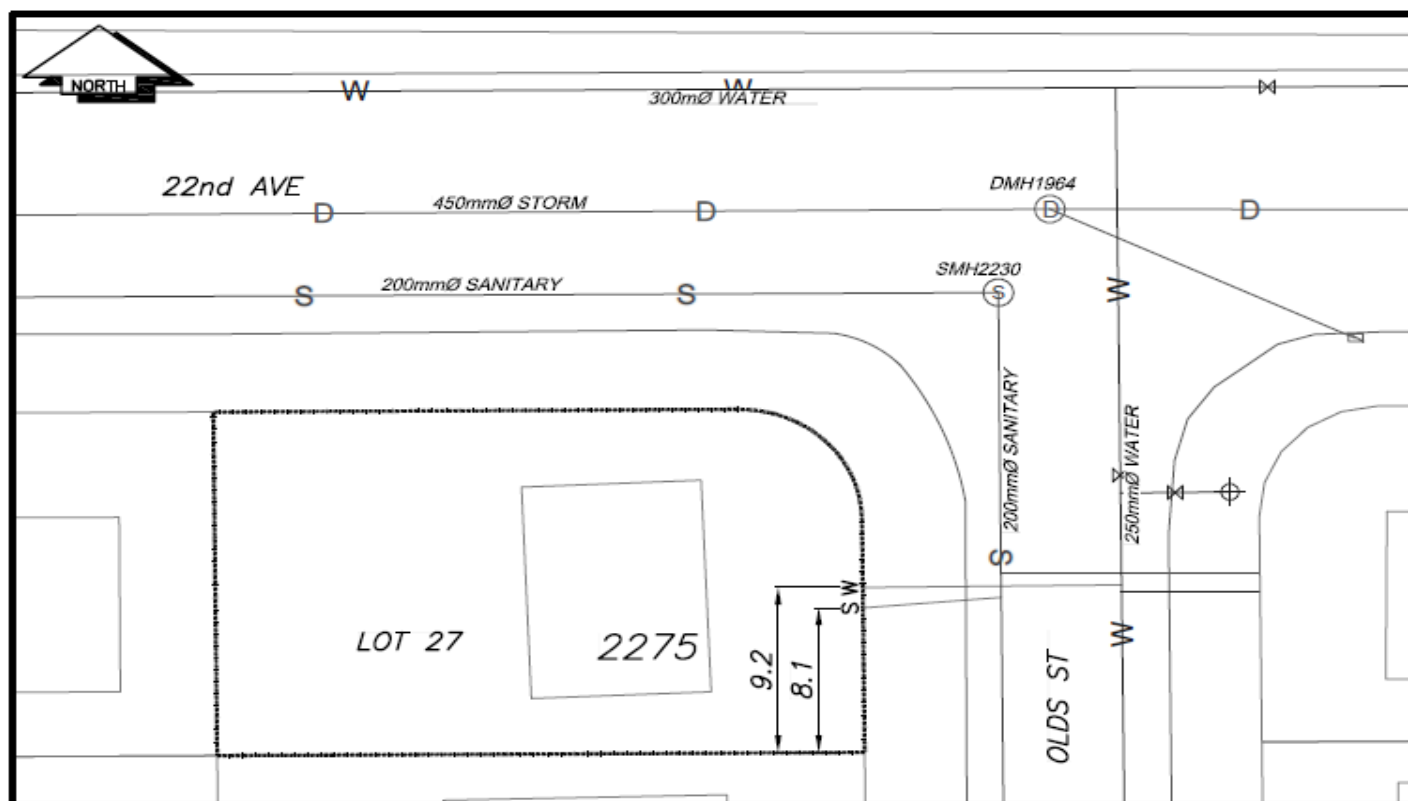

CS <sup>o</sup> CURB STOP	—S— WATER SERVICE	—o— STORM SERVICE
CO <sup>o</sup> CLEAN OUT	- - - - - SANITARY SERVICE	—G— GAS
⊗ WATER VALVE	—X— FIRE HYDRANT	- - - - - ENCUMBRANCE

**NOT TO SCALE**