



City of Prince George History Sheet

PID:	009444700
SD/MU:	
WO:	

Civic Address: 2463 Rush Pl

Legal Description: Lot: 8 District Lot: 2611 Plan: 21607


Service Type	Diameter (mm)	Material	Invert Elev at main (m)	Invert Elev at property line (m)	Invert Elev at service end (m)	Distance into property (m)	Installation Date
Sanitary	100mm	AC	-	580.30	-	-	December 1973
Water	20mm	Copper	-	-	-	-	December 1973
Storm	N/A	N/A	-	-	-	-	

Service Connection Location	Sanitary (m)	Storm (m)
100mm sanitary service connected to san Mh1031	-	
Distance from downstream Stm MH - towards upstream Stm MH -		

Power	Size	Communications	Size	Cable	Size	Gas	Size
BC Hydro	-	Telus	-	Shaw	-	FortisBC	-
Underground Service		Underground Service		Underground Service			

Installed by:	Survey Date:	-
Comments: Water service location confirmed on June 27, 2018.		

NOT TO SCALE The information contained herein is for internal use only.
Not to be relied on unless confirmed by site inspection and/or investigation.

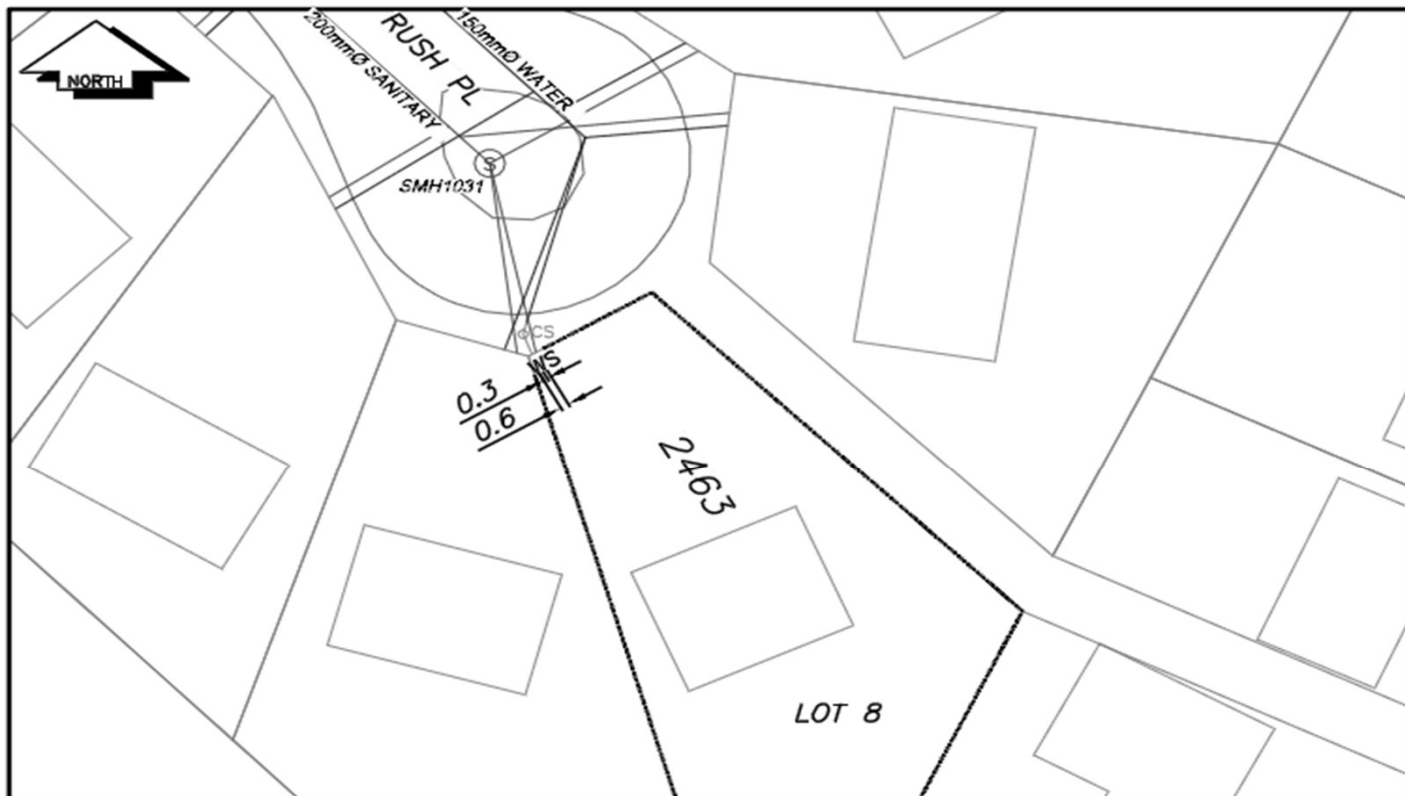

CS ^o CURB STOP	— W WATER SERVICE	— S STORM SERVICE
CO ^o CLEAN OUT	- - - S SANITARY SERVICE	— G GAS
⊗ WATER VALVE	⊗ FIRE HYDRANT	- - - ENCUMBERANCE

NOT TO SCALE