



City of Prince George History Sheet

PID:	009453229
	009453237
	009453245
MU:	101514
WO:	79000

Civic Address: 1240 2nd Avenue

Legal Description: Lot: 13, 14, 15 Block: 21 District Lot: 343 Plan: 1268


Service Type	Diameter (mm)	Material	Invert Elev at main (m)	Invert Elev at property line (m)	Invert Elev at service end (m)	Distance into property (m)	Installation Date
Sanitary (Lot 14)	100mm	PVC	-	-	-	-	January 1985
Water	100mm	PVC	-	-	-	-	June 2014
Storm	N/A	N/A	-	-	-	-	

Service Connection Location				Sanitary (m)	Storm (m)
Distance from downstream San MH	1875	towards upstream San MH	1883	41.40	
Distance from downstream Stm MH	-	towards upstream Stm MH	-		

Power	Size	Communications	Size	Cable	Size	Gas	Size
BC Hydro	-	Telus	-	Shaw	-	FortisBC	-
Overhead Service		Overhead Service		Overhead Service			

Installed by:	City of Prince George forces	Survey Date:	-
Comments:	New 100mm Water service to replace existing water service. Old water deactivated - Confirmed by John Handler		

**NOT TO SCALE The information contained herein is for internal use only.
Not to be relied on unless confirmed by site inspection and/or investigation.**

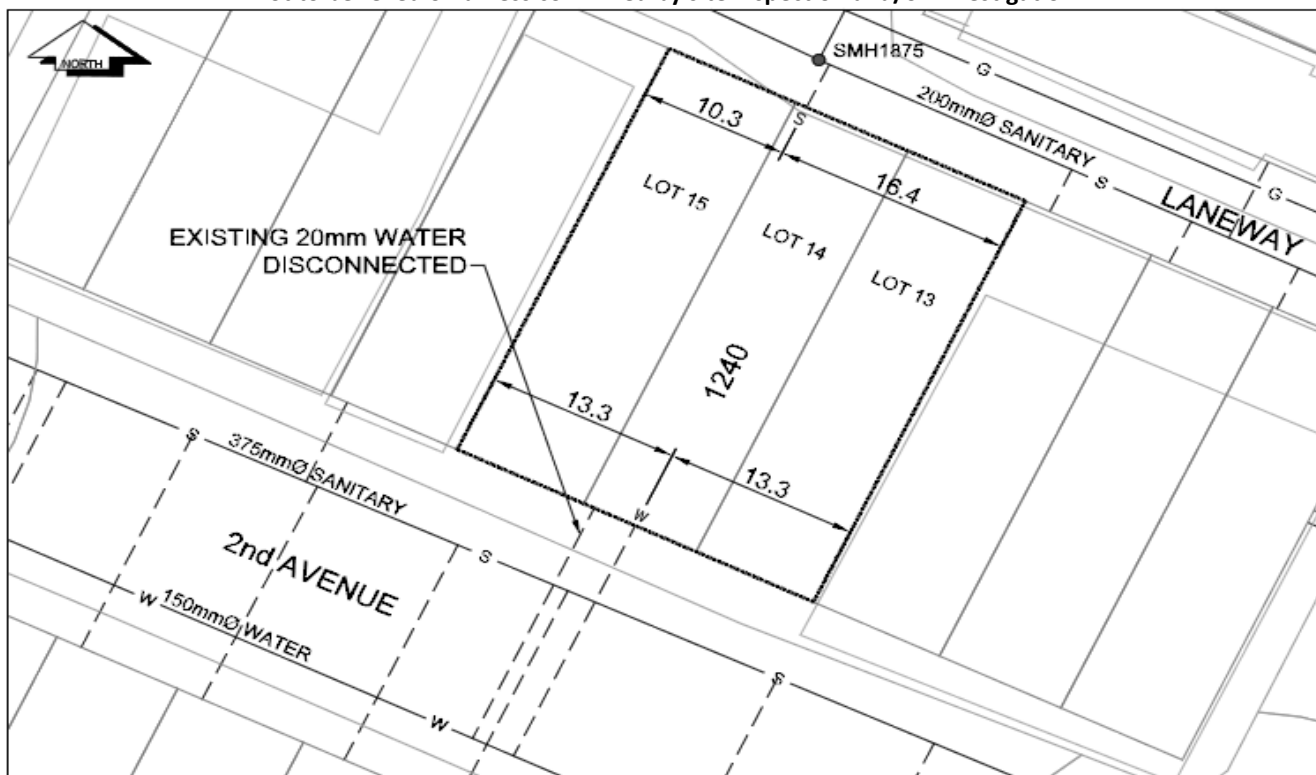

CS	CURB STOP	---	WATER SERVICE	---	STORM SERVICE
CO	CLEAN OUT	---	SANITARY SERVICE	---	GAS

NOT TO SCALE