


SHEET NUMBER		N <sup>o</sup> 4085		Roll Number 0090188979	
Legal:	LOT'S	7	BLOCK	D.L.	1427
Address:		746 AYR PL.			
Sanitary Connection:	#	SIZE	4"	MATERIAL	PVC.
				INV.	CONNECTED
Water Connection	#	SIZE	3/4"	MATERIAL	Cu.
				METER	CONNECTED
Storm Connection:	#	SIZE		MATERIAL	
				INV.	CONNECTED
Cash Receipt No's:	WATER		SANITARY		STORM
CURB FROM PROPERTY LINE			PAVEMENT WIDTH		
B.C. HYDRO			UNDERGROUND CONNECTION		
B.C. TELEPHONE			UNDERGROUND CONNECTION		
INLAND GAS					
Information Sheets:					
Comments:					

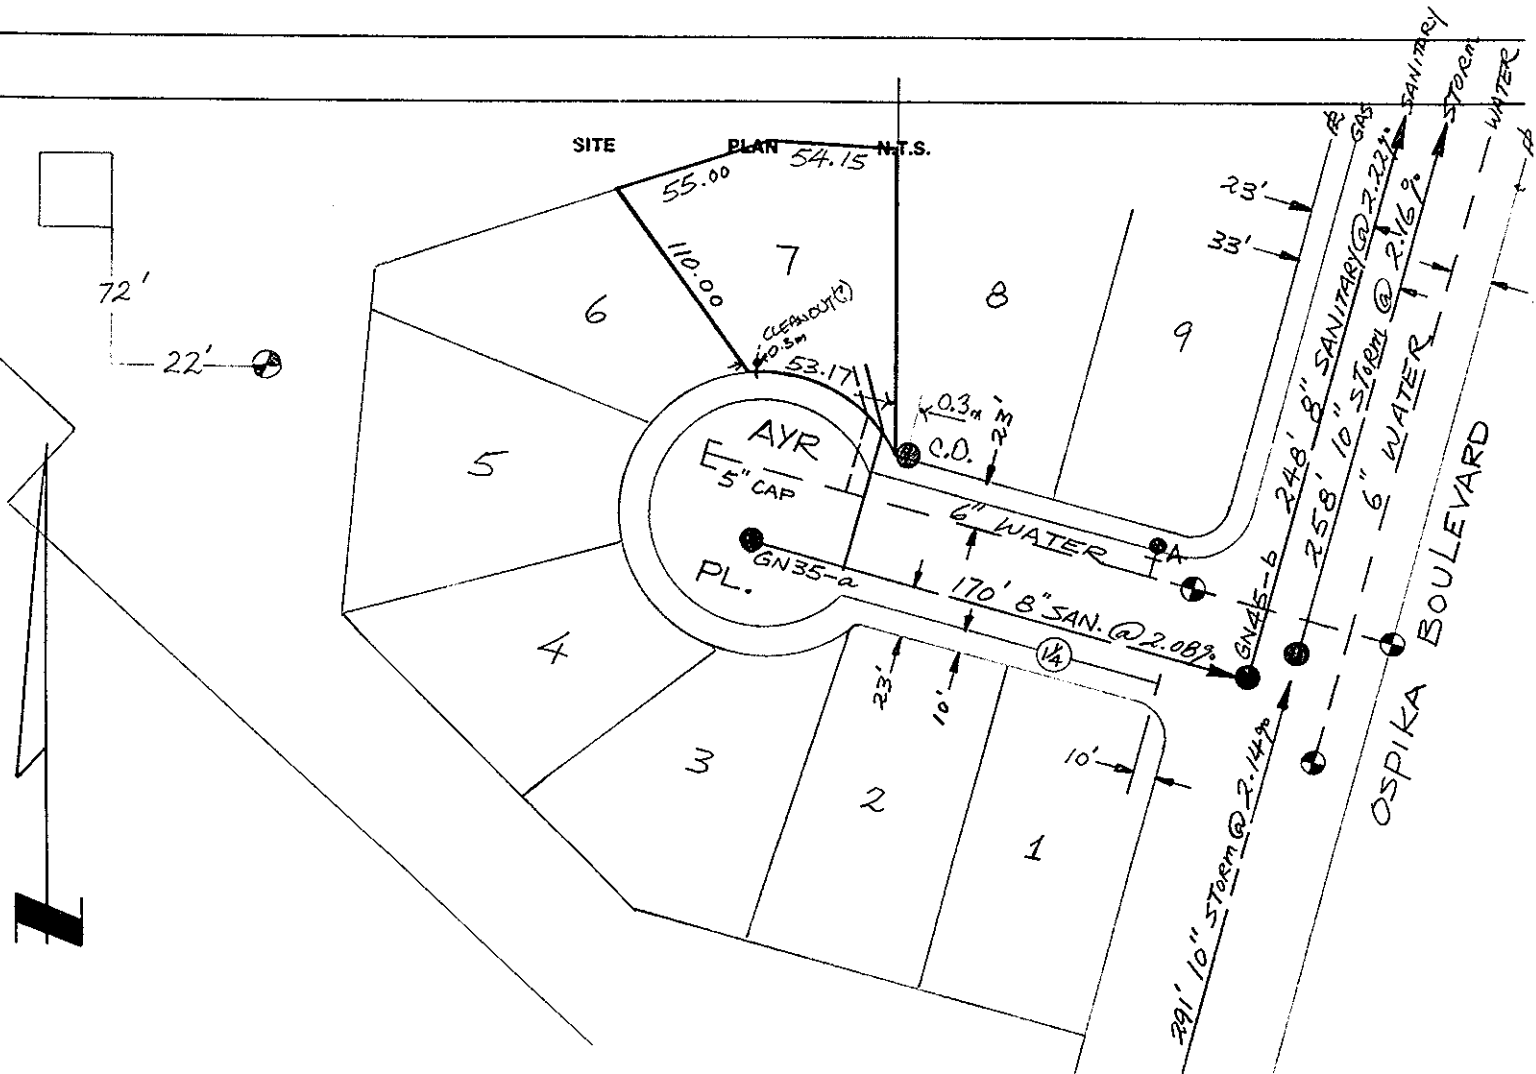

**REPORT TO RECORDS**

## SEWER SERVICE INFORMATION

Lot No. 7-1427-21503 Block \_\_\_\_\_ D.L. \_\_\_\_\_


Address 746 AYR.

Size of Connection ☒ 100mm ☐ 150mm ☐ 200mm ☐ Other \_\_\_\_\_

Type of Connection ☐ Transite ☐ PVC ☐ Other \_\_\_\_\_

Type of Cap ☐ Transite ☒ Cast Iron

## LOCATION SKETCH

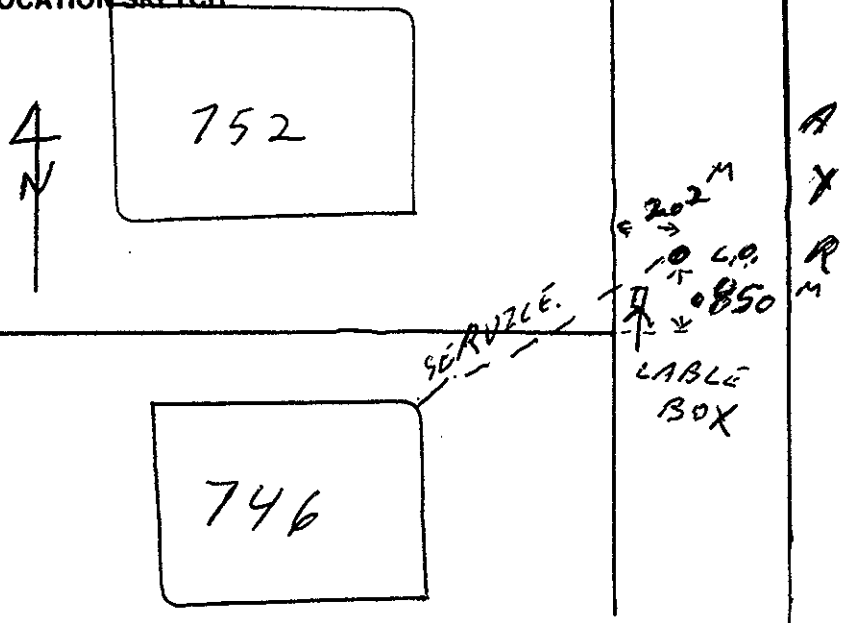

Field Location By A. ST. CROIX Date JAN. 29/01

Checked by Foreman - Sewer Division \_\_\_\_\_