



City of Prince George History Sheet

PID:	009536353
	009536329
	009536311
MU:	101357
WO:	67928

Civic Address: 260, 270, 280 Victoria St
1480, 1490 3rd Ave

Legal Description: Lot: 18, 19, 20 Block: 46 District Lot: 343 Plan: 1268


Service Type	Diameter (mm)	Material	Invert Elev at main (m)	Invert Elev at property line (m)	Invert Depth at service end (m)	Distance into property (m)	Installation Date
Sanitary	150mm	AC	-	-	-	-	January 1959
Sanitary	100mm	AC	572.43	572.66	2.08	-	January 1959
Water (NW)	150mm	PVC	-	-	-	-	November 2012
Water (SE)	100mm	Cast Iron	-	-	-	-	January 1957
Storm	N/A	N/A	-	-	-	-	

Service Connection Location	Sanitary (m)	Storm (m)
150mm Sanitary service connected to San MH1873	-	
Distance from downstream San MH 1876 towards upstream San MH 1873	81.38	

Power	Size	Communications	Size	Cable	Size	Gas	Size
BC Hydro	-	Telus	-	Shaw	-	FortisBC	-
Overhead Service		Overhead Service		Overhead Service			

Installed by:	City of Prince George forces	Survey Date:	-
Comments:			

NOT TO SCALE The information contained herein is for internal use only.
Not to be relied on unless confirmed by site inspection and/or investigation.

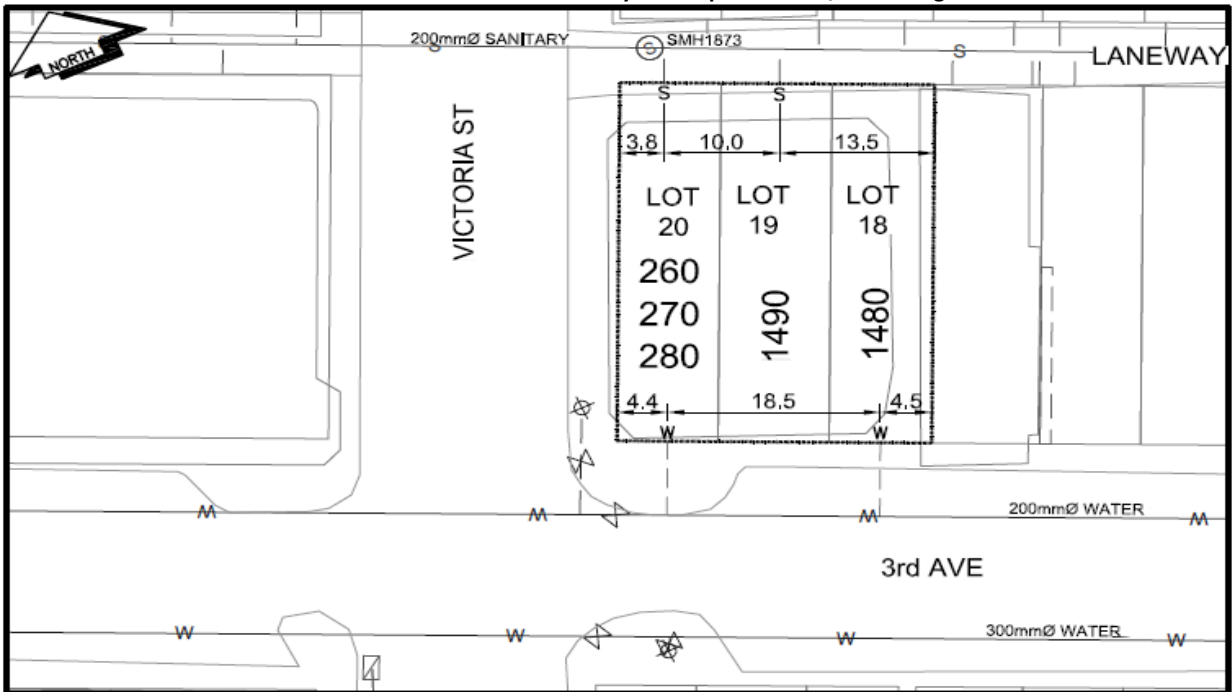

CS CURB STOP	--- WATER SERVICE	--- STORM SERVICE
CO CLEAN OUT	--- SANITARY SERVICE	--- GAS
WATER VALVE	--- FIRE HYDRANT	--- ENCUMBRANCE

NOT TO SCALE