



City of Prince George History Sheet

PID:	003978184
	009538071
	009538101
	009538119
	009538135
	015975053
SD/MU:	
WO:	

Civic Address: 1924 3rd Ave.

Legal Description: Lot: 46 51 Block: 48 District Lot: 343 Plan: 1268


Service Type	Diameter (mm)	Material	Invert Elev at main (m)	Invert Elev at property line (m)	Invert Elev at service end (m)	Distance into property (m)	Installation Date
Sanitary (S1)	100mm	AC	-	-	-	-	January 1957
Sanitary (S2)	100mm	AC	-	-	-	-	January 1957
Water	25mm	Copper	-	-	-	-	January 1957
Storm	150mm	AC	-	-	-	-	January 1961

Service Connection Location				Sanitary (m)	Storm (m)
Distance from downstream San MH	1005	towards upstream San MH	997	30.33	
Distance from downstream San MH	1005	towards upstream San MH	997	10.78	
150mm Storm service connected to Stm MH1077					

Power	Size	Communications	Size	Cable	Size	Gas	Size
BC Hydro	-	Telus	-	Shaw	-	FortisBC	-
Overhead Service		Overhead Service		Overhead Service			

Installed by:	Survey Date:	-
Comments:		

NOT TO SCALE The information contained herein is for internal use only.
Not to be relied on unless confirmed by site inspection and/or investigation.

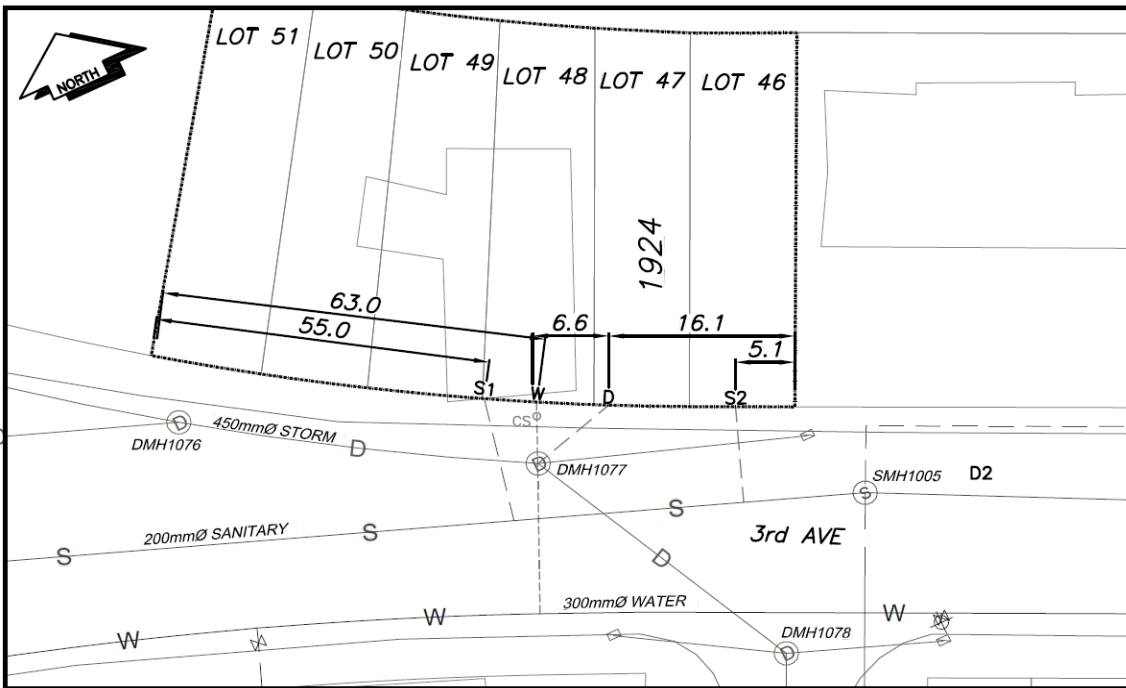

CS ^o CURB STOP	—W— WATER SERVICE	—S— STORM SERVICE
CO ^o CLEAN OUT	--- SANITARY SERVICE	—G— GAS
⊗ WATER VALVE	⊗ FIRE HYDRANT	--- ENCUMBRANCE

NOT TO SCALE