



# City of Prince George History Sheet

PID:	009558063
SD/MU:	
WO:	

Civic Address: 2863 Killarney Dr

Legal Description: Lot: 99 District Lot: 4046 Plan: 21288


Service Type	Diameter (mm)	Material	Invert Elev at main (m)	Invert Elev at property line (m)	Invert Elev at service end (m)	Distance into property (m)	Installation Date
Sanitary	100mm	PVC	741.67	742.86	-	-	October 2016
Water	20mm	Copper	-	-	-	-	January 1972
Storm	N/A	N/A	-	-	-	-	

Service Connection Location						Sanitary (m)	Storm (m)
Distance from downstream San MH			-	towards upstream San MH		-	
Distance from downstream Stm MH			-	towards upstream Stm MH		-	

Power	Size	Communications	Size	Cable	Size	Gas	Size
BC Hydro	-	Telus	-	Shaw	-	FortisBC	-
Overhead Service		Overhead Service		Overhead Service			

Installed by:	City of Prince George forces	Survey Date:	-
Comments:			

**NOT TO SCALE** The information contained herein is for internal use only.  
Not to be relied on unless confirmed by site inspection and/or investigation.

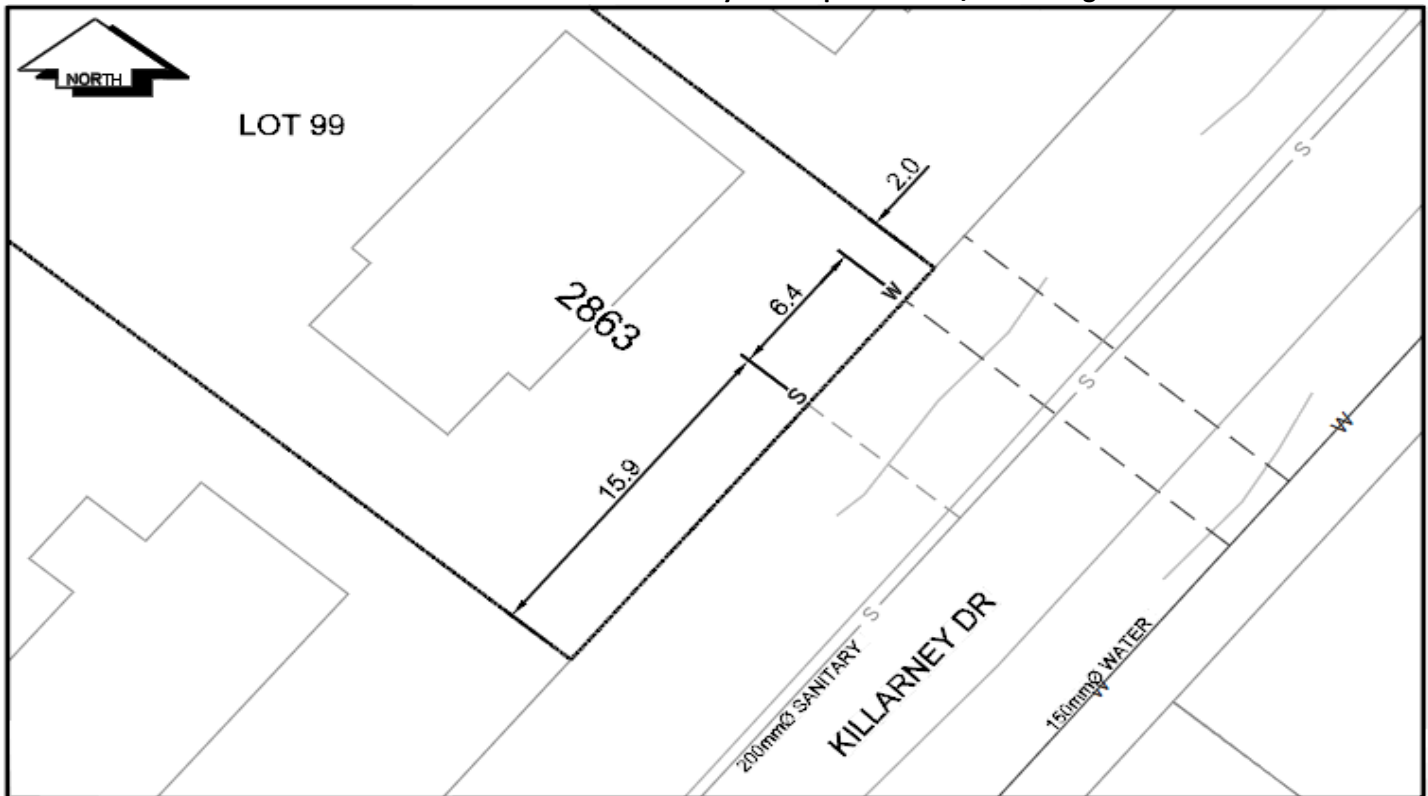

CS CURB STOP	--- WATER SERVICE	--- STORM SERVICE
CO CLEAN OUT	--- SANITARY SERVICE	--- GAS
WATER VALVE	--- FIRE HYDRANT	--- ENCUMBRANCE

**NOT TO SCALE**