
City of Prince George HISTORY SHEET

 $\langle \rangle$

SHEET NUMBER	1133	f)		Roll Number		
Legal: LOT'S	/2	BLOCK		D.L. 2/00	PLAN 2//88	
Address:	3996	GILBERT	DR.			
Sanitary Connection:	#	SIZE	MATERIAL	INV,	CONNECTED	
Water Connection #		SIZE	MATERIAL	METER	CONNECTED	
Storm Connection:		ŚIZE	MATERIAL	INV.	CONNECTED	
Cash Receipt No's:	WATER		SANITARY		STORM	
CURB FROM PROPERTY LINE			PAVEMENT WIDTH			
B.C. HYDRO		UNDERGROUND CONNECTION				
B.C. TELEPHONE		UNDERGROUND CONNECTION				
INLAND GAS					· ··	
Information Sheets:	***					
Comments:						
•						

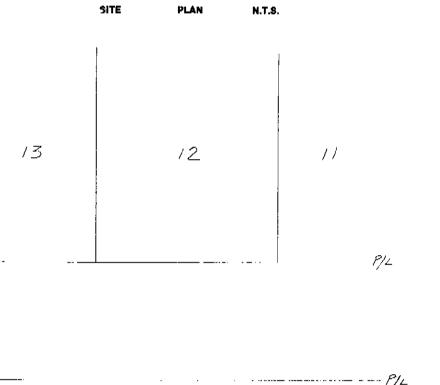

GILBERT DR.