



City of Prince George History Sheet

PID:	009573950
MU:	101600
WO:	83309

Civic Address: 350 Burden St

Legal Description: Lot: 16 Block: 55 District Lot: 343 Plan: 1268


Service Type	Diameter (mm)	Material	Invert Elev at main (m)	Invert Elev at property line (m)	Invert Elev at service end (m)	Distance into property (m)	Installation Date
Sanitary	100mm	PVC	-	-	-	-	April 2015
Water	20mm	Copper	-	-	-	-	January 1958
Storm	N/A	N/A	-	-	-	-	

Service Connection Location				Sanitary (m)	Storm (m)
Distance from downstream San MH	1650	towards upstream San MH	1647	52.30	
Distance from downstream Stm MH	-	towards upstream Stm MH	-	-	

Power	Size	Communications	Size	Cable	Size	Gas	Size
BC Hydro	-	Telus	-	Shaw	-	FortisBC	-
Overhead Service		Overhead Service		Overhead Service			

Installed by:	City of Prince George forces	Survey Date:	-
Comments:			
9573950			

NOT TO SCALE The information contained herein is for internal use only.
Not to be relied on unless confirmed by site inspection and/or investigation.

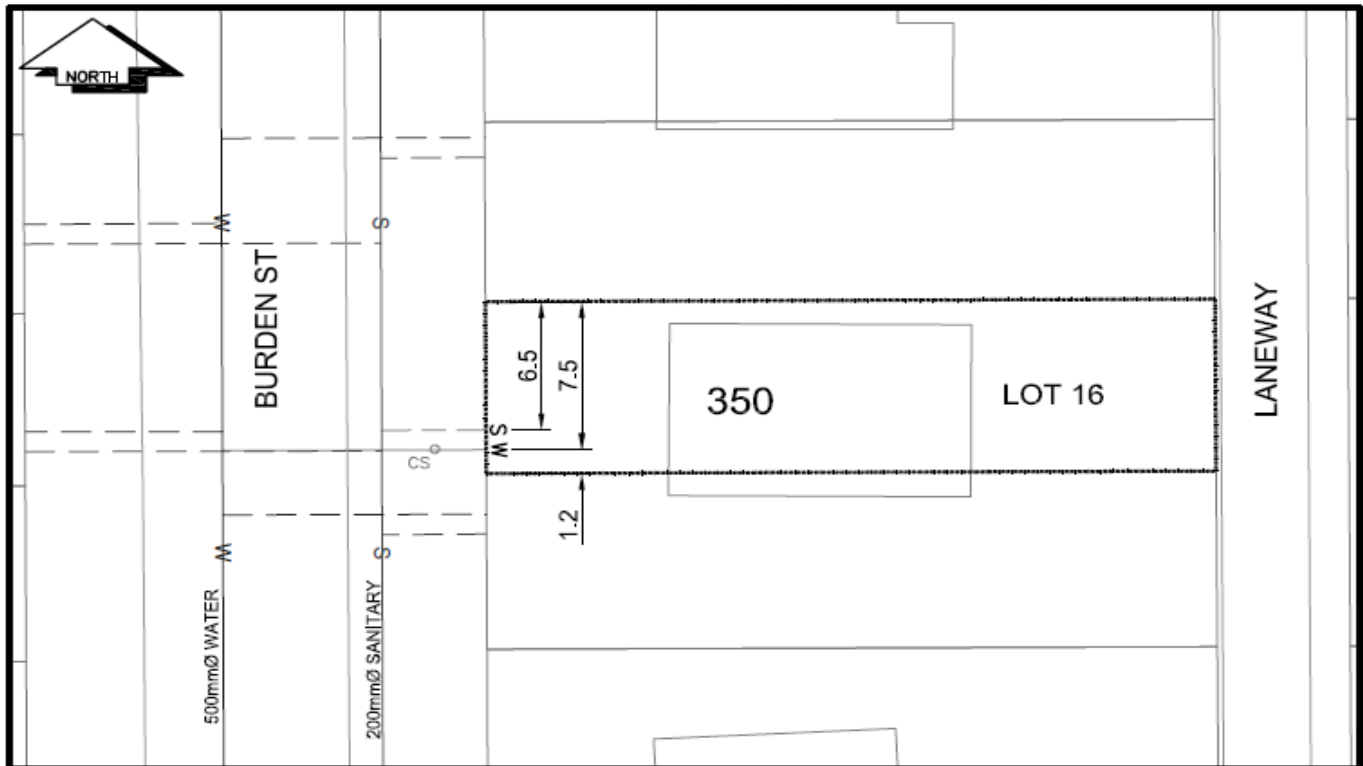

CS ^o CURB STOP	--- W WATER SERVICE	--- S SANITARY SERVICE	--- G GAS	--- S STORM SERVICE
CO ^o CLEAN OUT	--- F FIRE HYDRANT	--- E ENCUMBRANCE		
WATER VALVE				

NOT TO SCALE