



# City of Prince George History Sheet

|      |             |
|------|-------------|
| PID: | 009574263   |
| MU:  | 101161      |
| WO:  | 58653/58654 |

Civic Address: 327 Wainwright St

Legal Description: Lot: 4 Block: 56 District Lot: 3 Plan: 1268


| Service Type | Diameter (mm) | Material | Invert Elev at main (m) | Invert Elev at property line (m) | Invert Elev at service end (m) | Distance into property (m) | Installation Date |
|--------------|---------------|----------|-------------------------|----------------------------------|--------------------------------|----------------------------|-------------------|
| Sanitary     | 100mm         | PVC      | -                       | -                                | -                              | -                          | Jun 2011          |
| Water        | 20mm          | Copper   | -                       | -                                | -                              | -                          | Jun 2011          |
| Storm        | N/A           | N/A      | -                       | -                                | -                              | -                          |                   |

| Service Connection Location     |      |                         |      | Sanitary (m) | Storm (m) |
|---------------------------------|------|-------------------------|------|--------------|-----------|
| Distance from downstream San MH | 1653 | towards upstream San MH | 1645 | 76.47        |           |
| Distance from downstream Stm MH | -    | towards upstream Stm MH | -    |              |           |

| Power            | Size | Communications   | Size | Cable            | Size | Gas      | Size |
|------------------|------|------------------|------|------------------|------|----------|------|
| BC Hydro         | -    | Telus            | -    | Shaw             | -    | FortisBC | -    |
| Overhead Service |      | Overhead Service |      | Overhead Service |      |          |      |

|               |                              |              |   |
|---------------|------------------------------|--------------|---|
| Installed by: | City of Prince George forces | Survey Date: | - |
| Comments:     |                              |              |   |

**NOT TO SCALE** The information contained herein is for internal use only.  
Not to be relied on unless confirmed by site inspection and/or investigation.

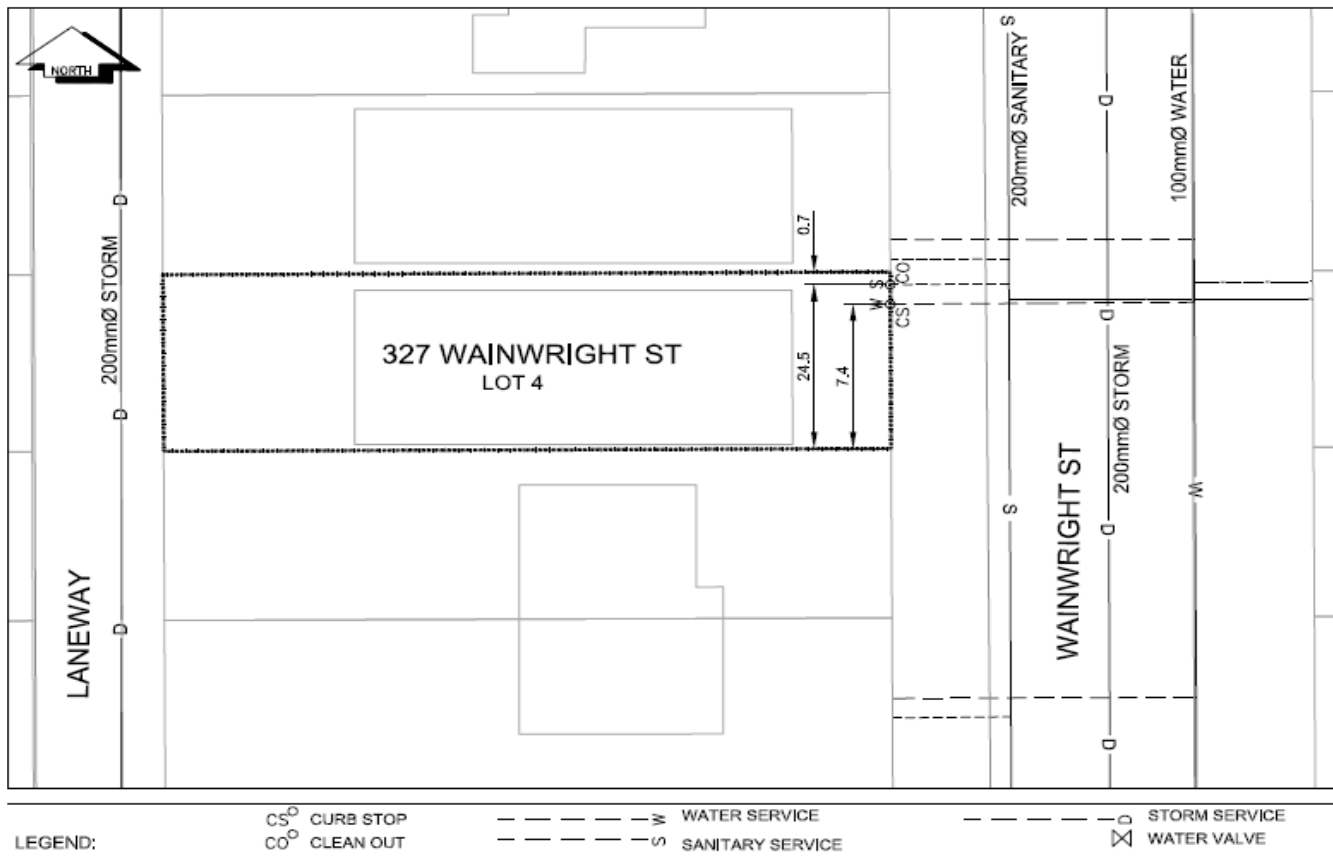

**NOT TO SCALE**